

AS-BUILT EXAMPLES

NOT TO SCALE

NO. ISSUE/REVISION DATE


PROJECT \_\_\_\_\_

SCALE \_\_\_\_\_

DRAWN BY \_\_\_\_\_

DATE \_\_\_\_\_


DRAWING NO.  
OFFICE SPACE

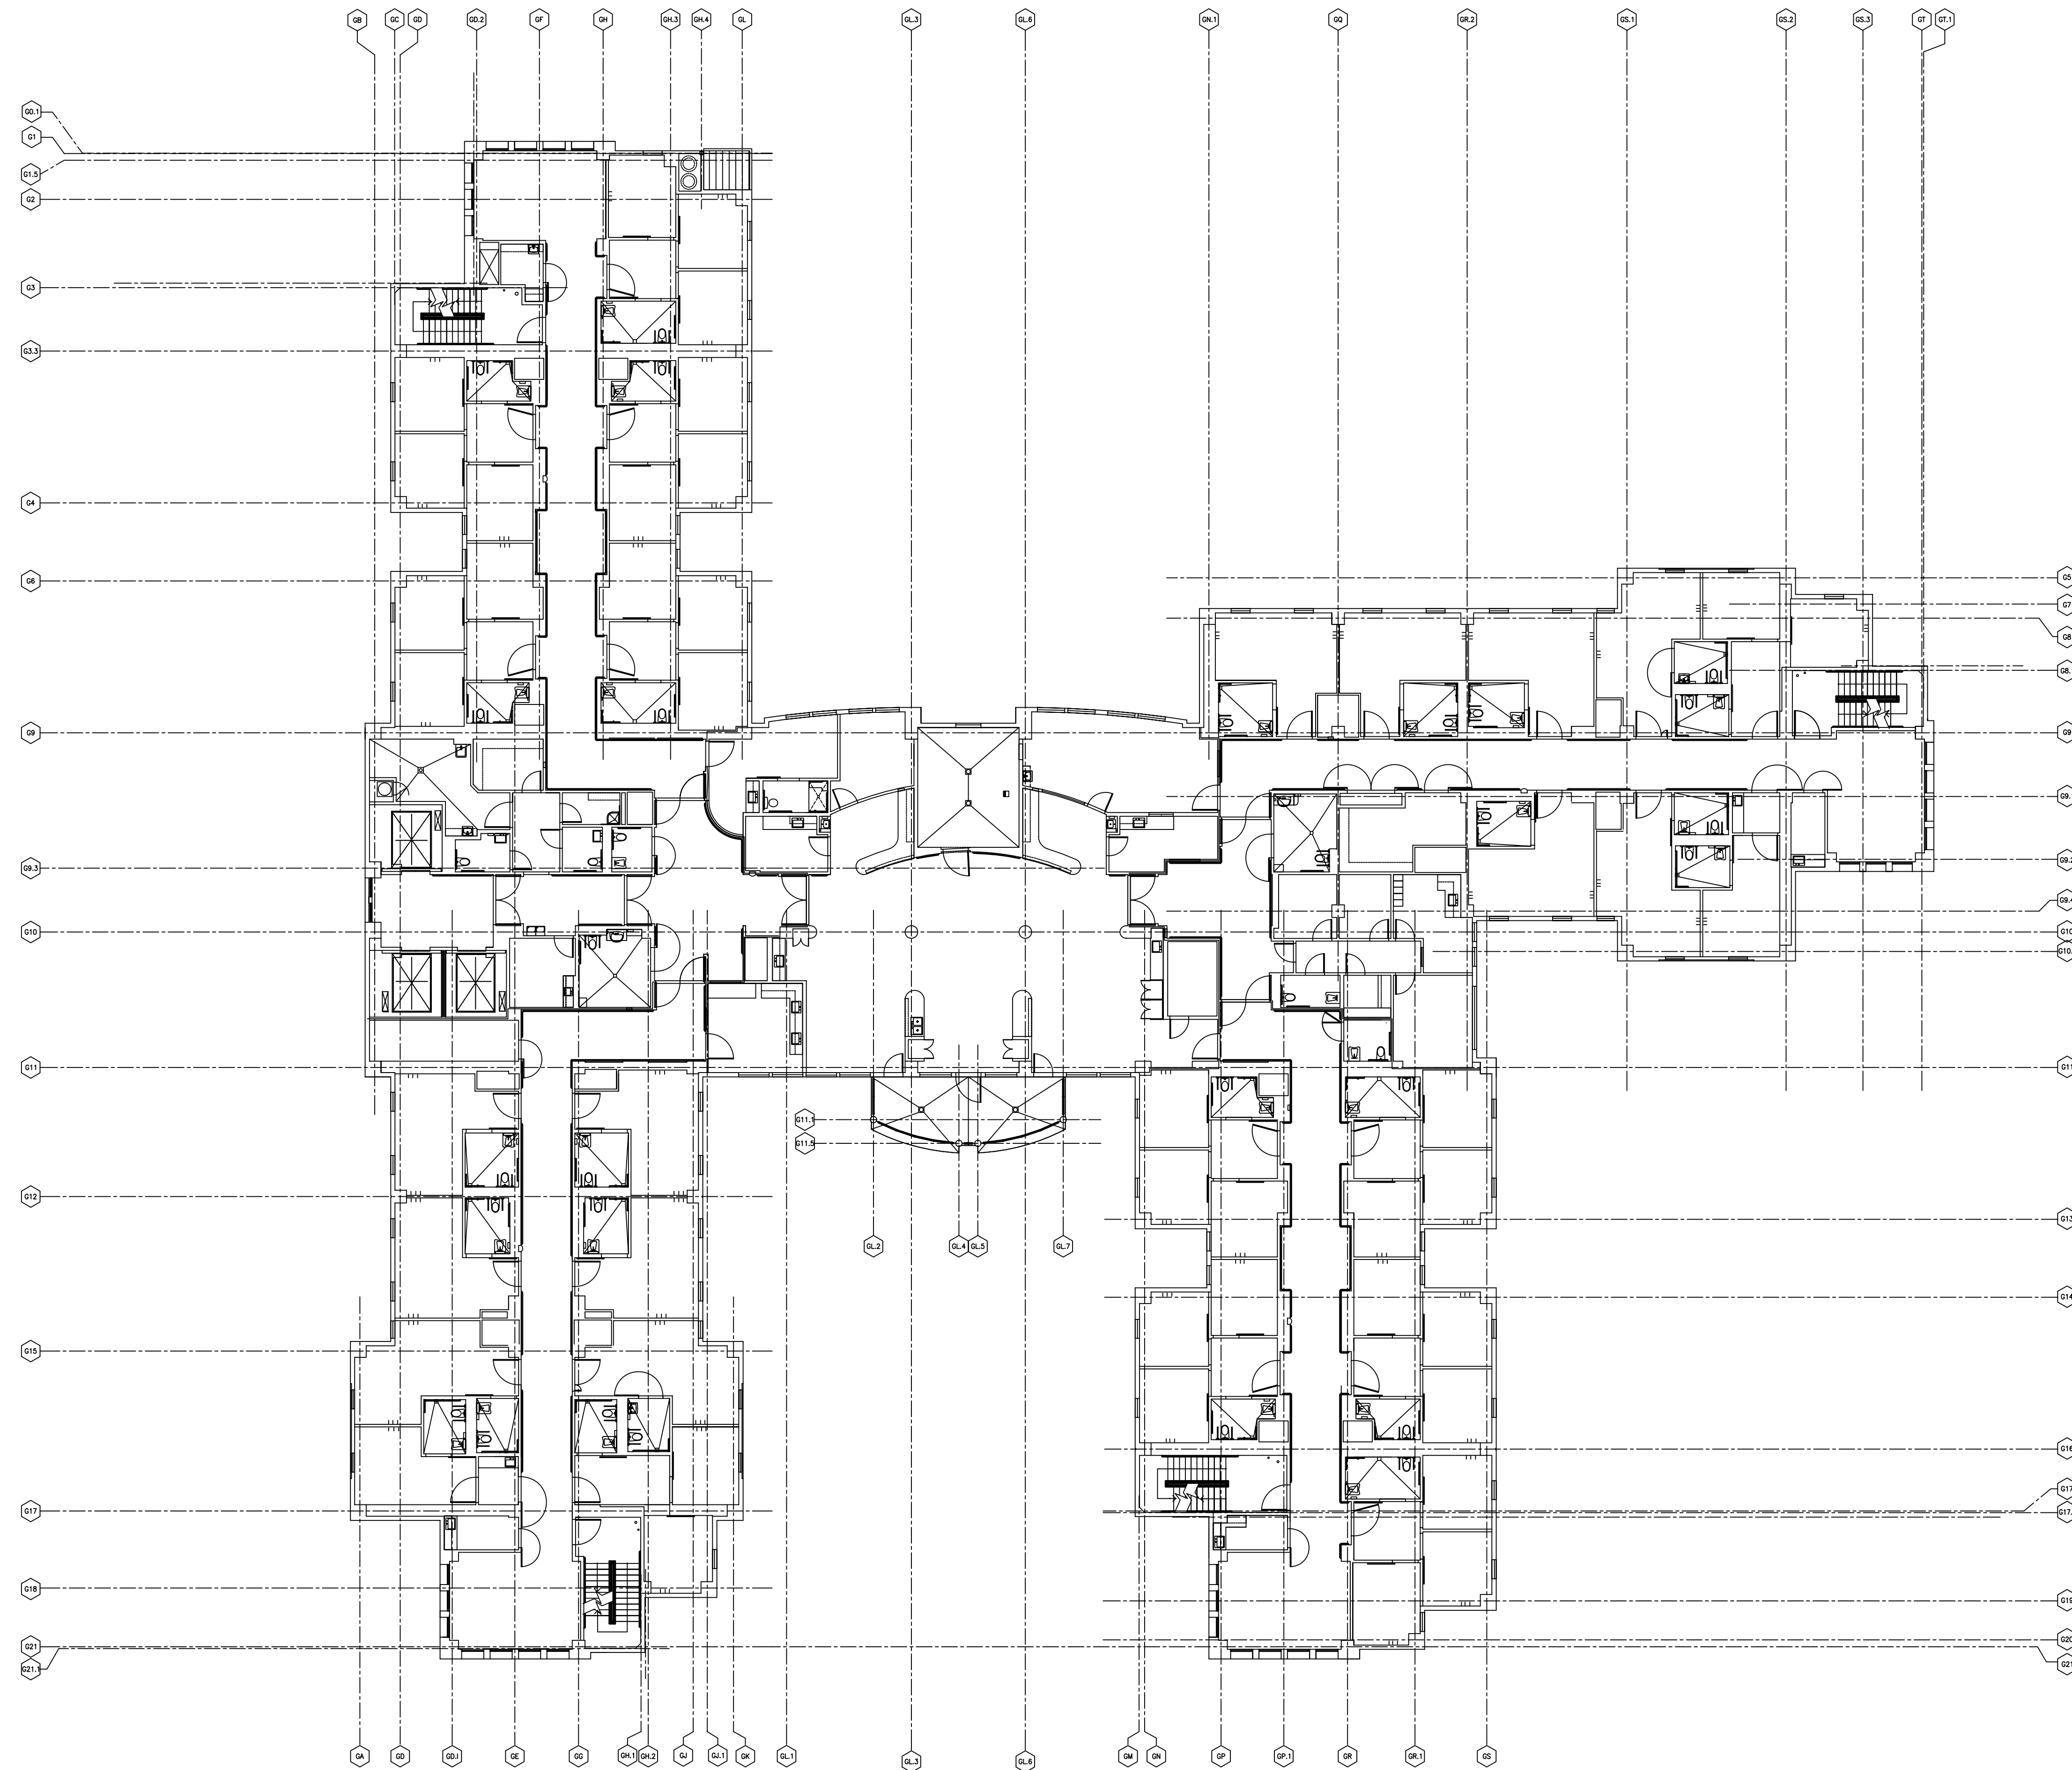

AS-BUILT EXAMPLES  
NOT TO SCALE

NO. ISSUE/REVISION DATE


PROJECT \_\_\_\_\_  
SCALE \_\_\_\_\_  
DRAWN BY \_\_\_\_\_  
DATE \_\_\_\_\_  
DRAWING NO. \_\_\_\_\_  
OFFICE SPACE

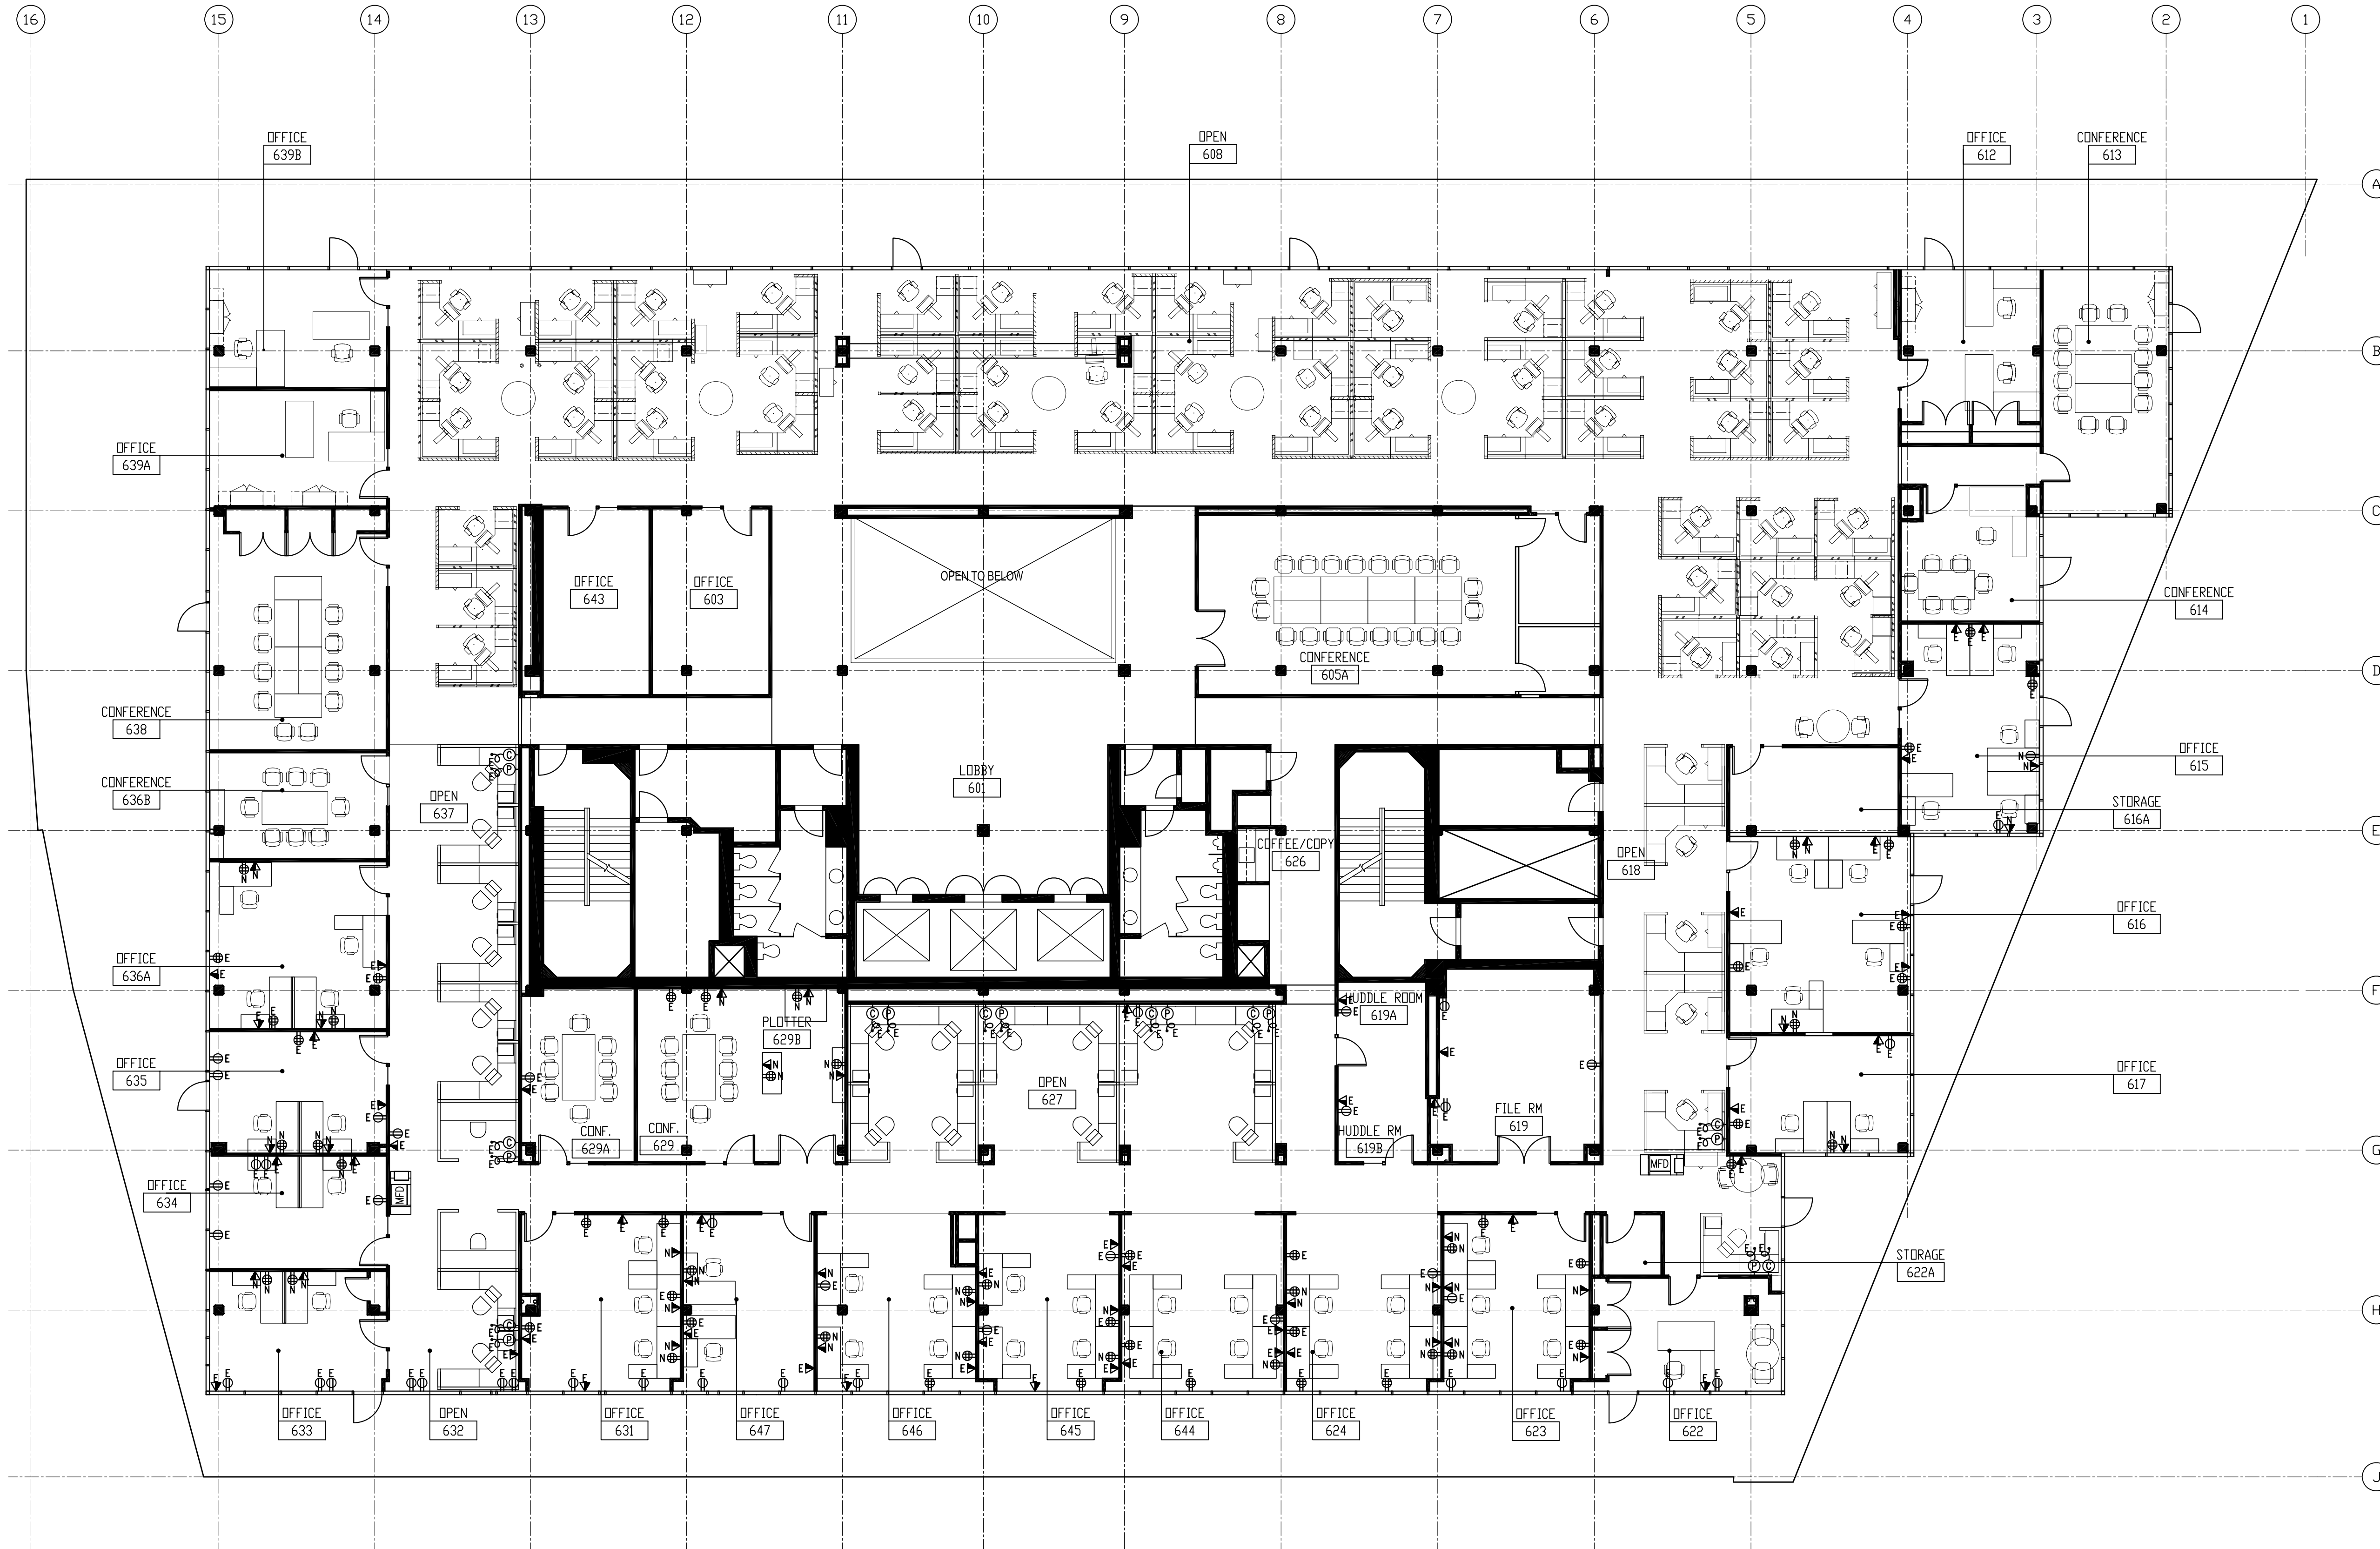

AS-BUILT EXAMPLES  
NOT TO SCALE

NO. ISSUE/REVISION DATE

PROJECT \_\_\_\_\_  
SCALE \_\_\_\_\_  
DRAWN BY \_\_\_\_\_  
DATE \_\_\_\_\_  
DRAWING NO. \_\_\_\_\_  
OFFICE SPACE

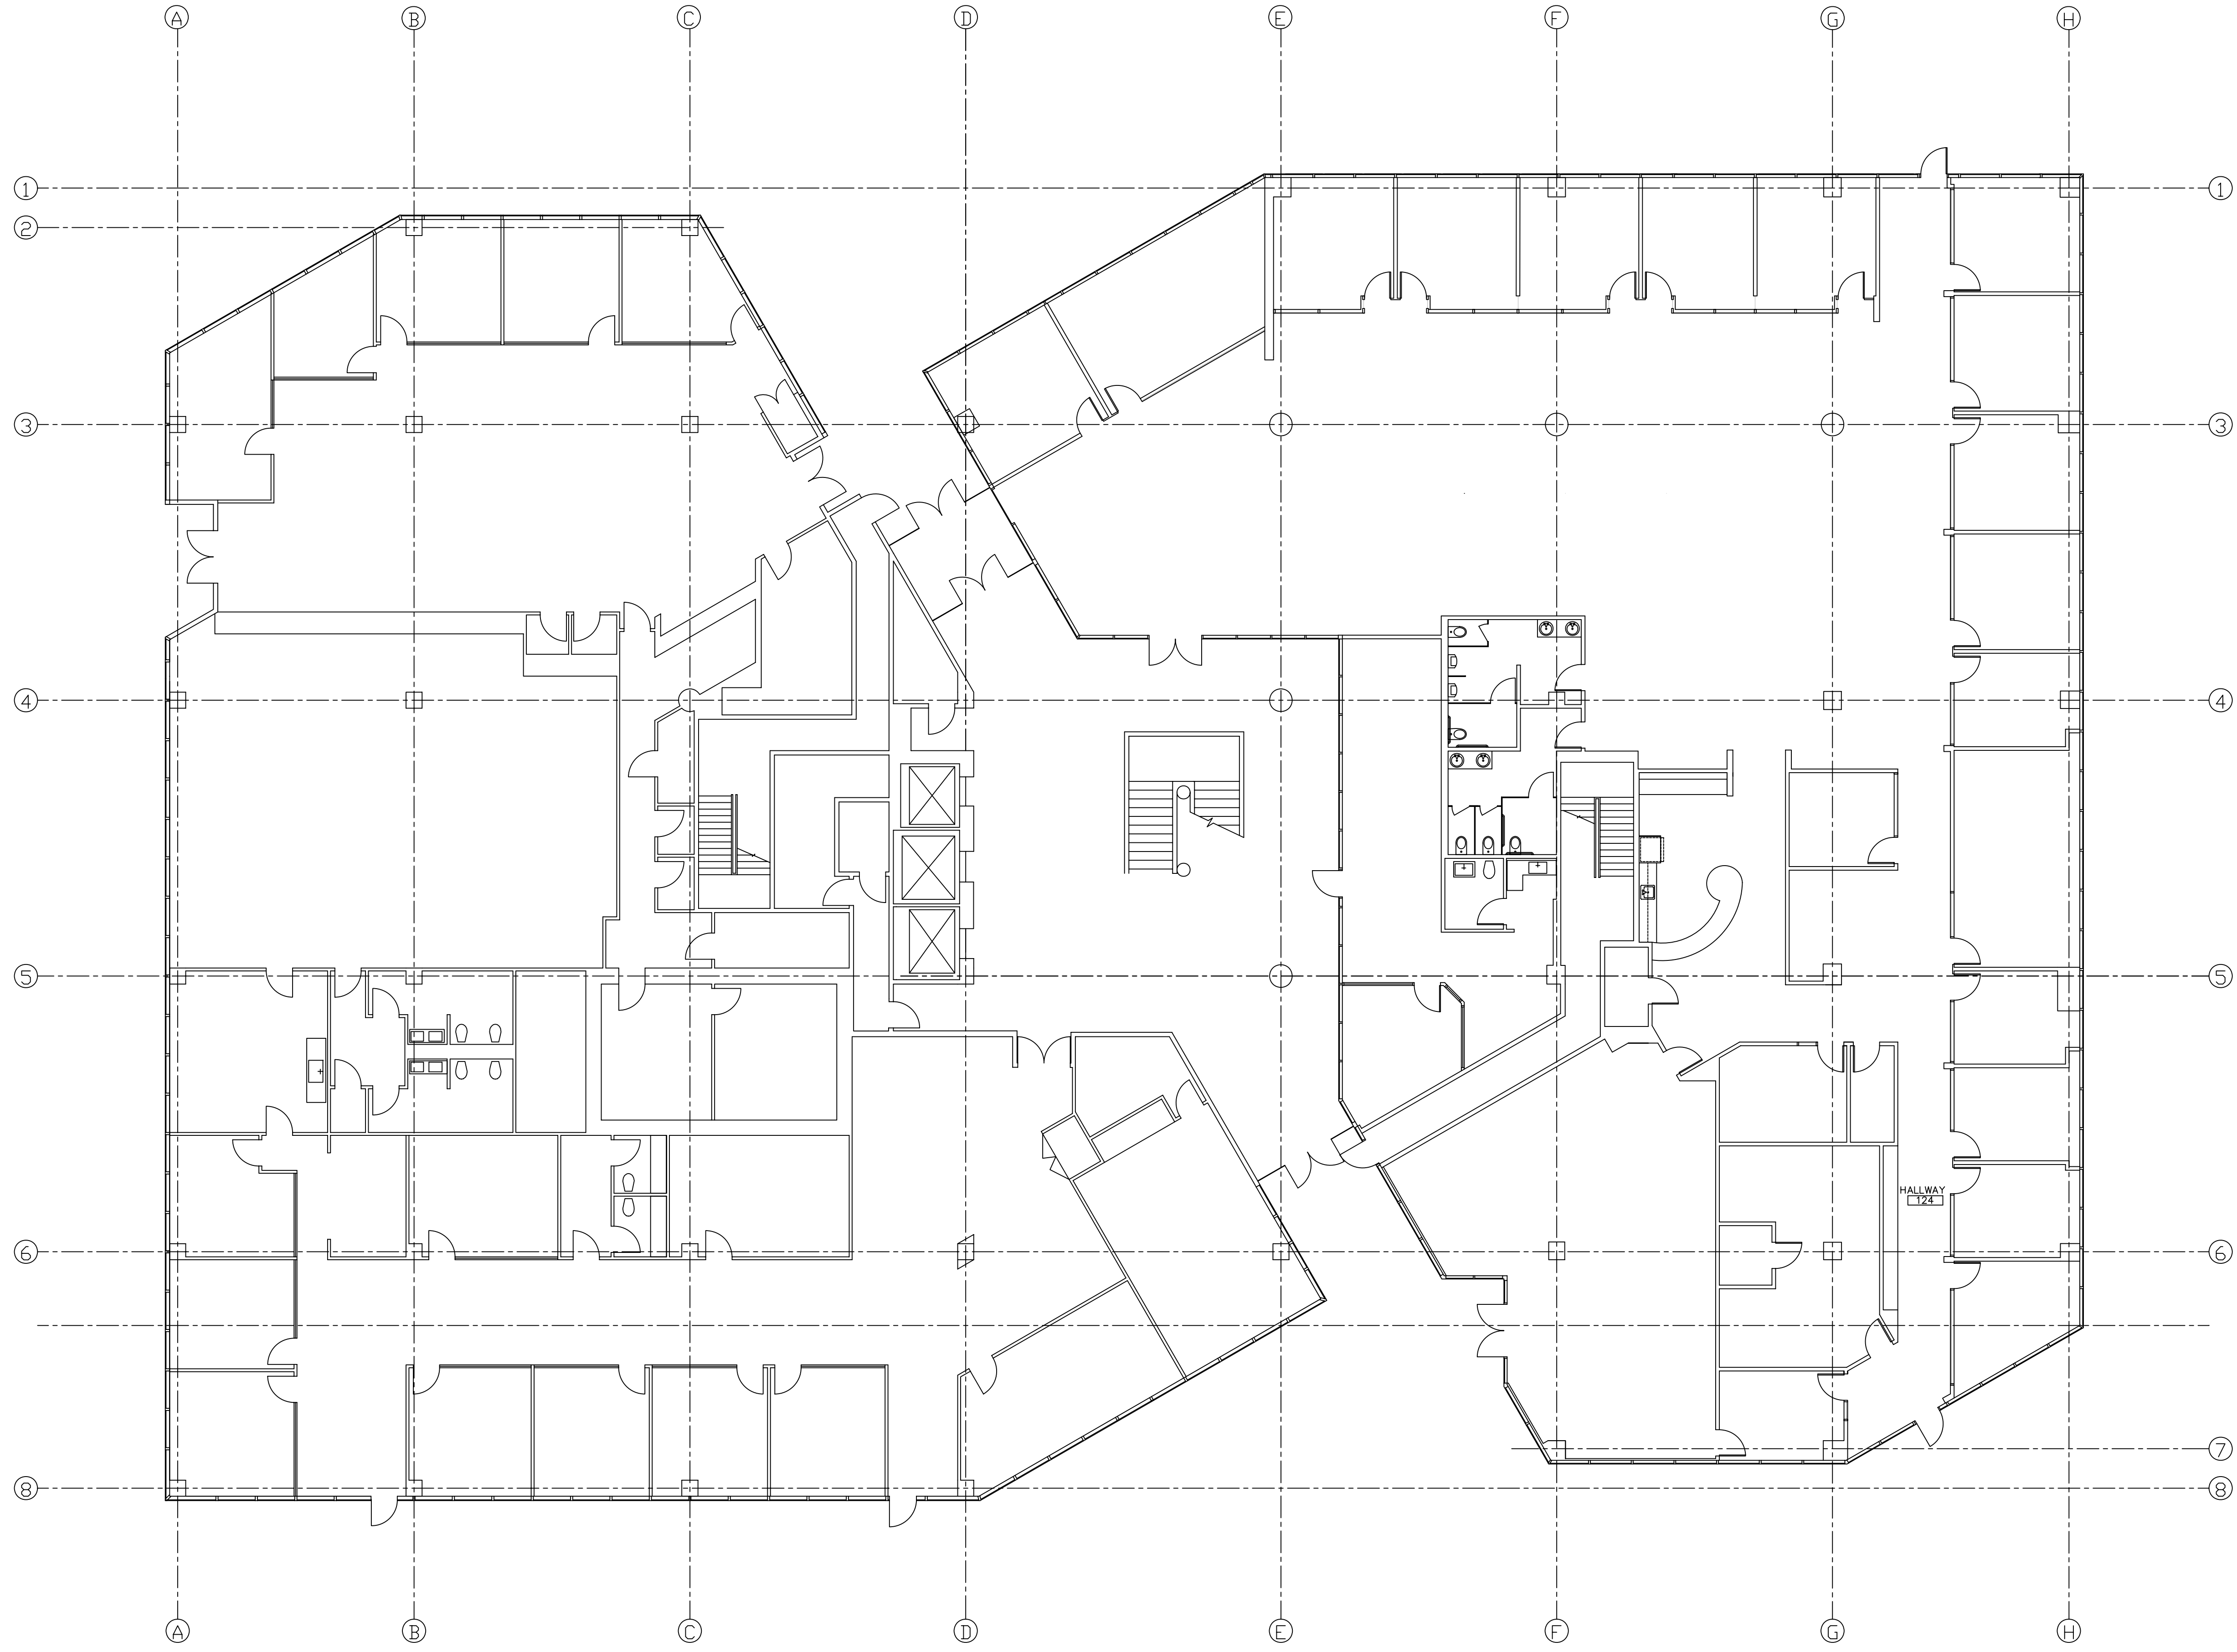

**AS-BUILT EXAMPLES**

NOT TO SCALE

NO. ISSUE/REVISION DATE


PROJECT \_\_\_\_\_

SCALE \_\_\_\_\_

DRAWN BY \_\_\_\_\_

DATE \_\_\_\_\_

DRAWING NO.  
**OFFICE SPACE**

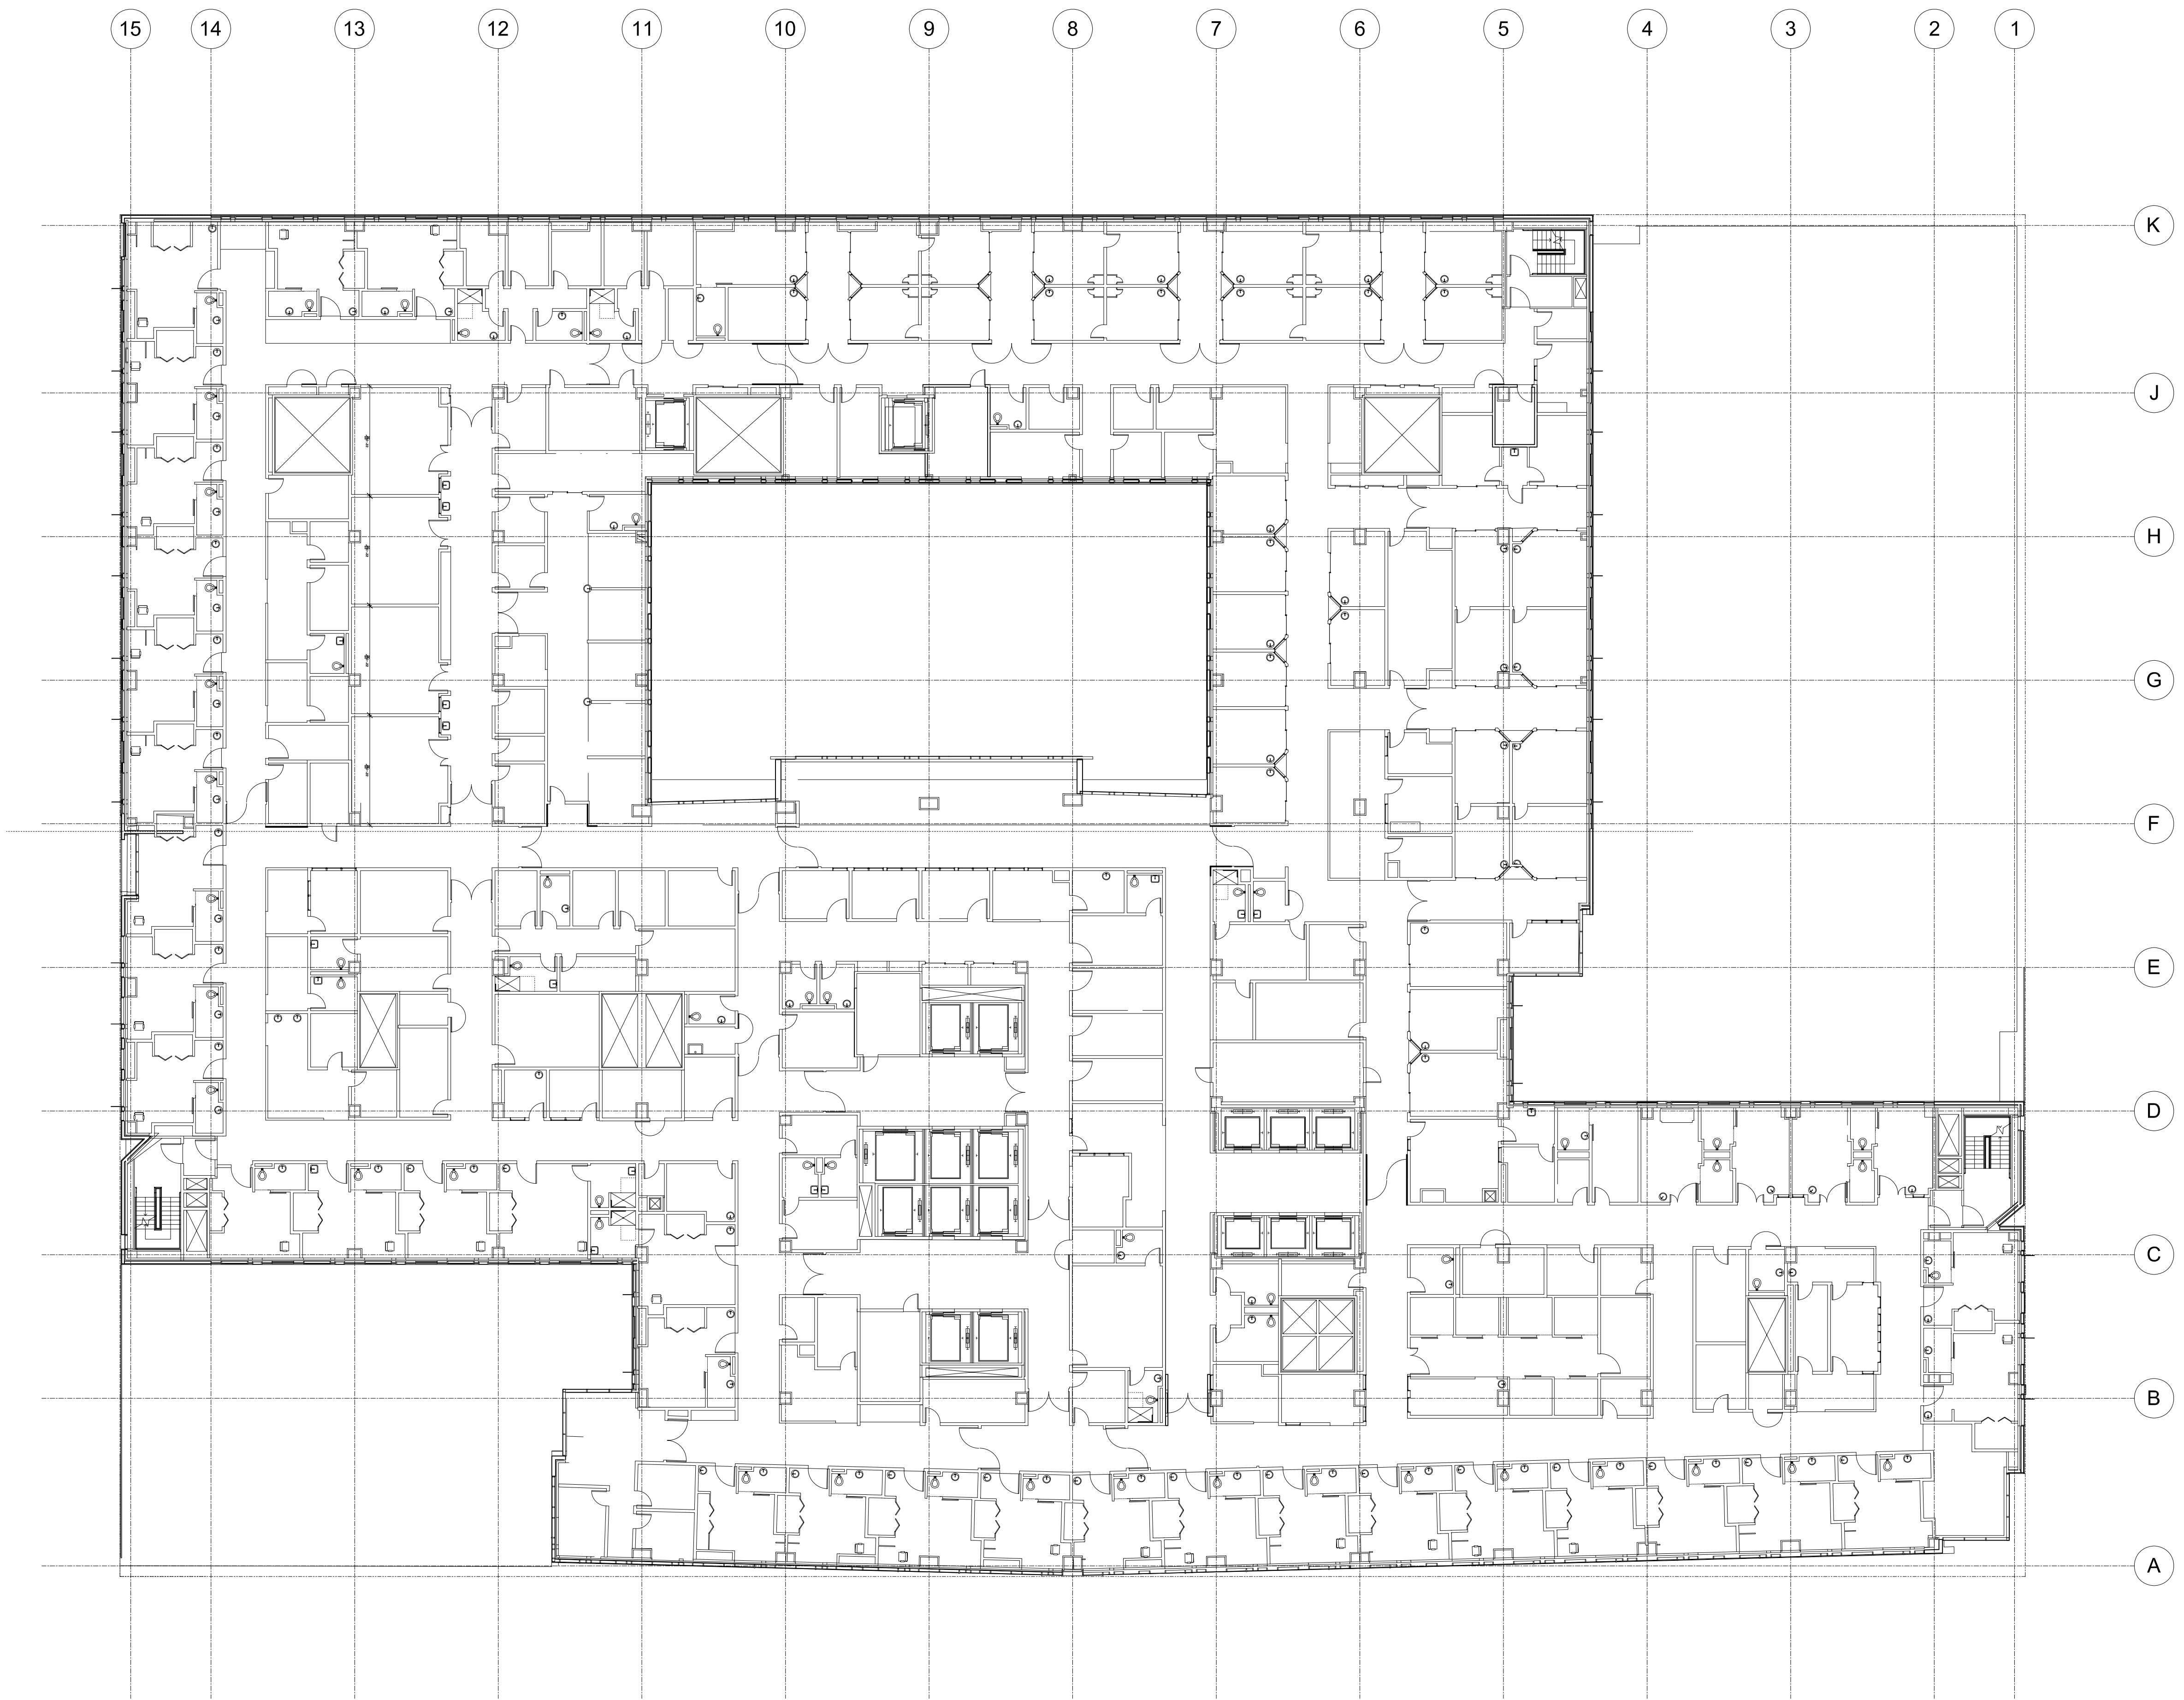

AS-BUILT EXAMPLES

NOT TO SCALE

NO. ISSUE/REVISION DATE

PROJECT \_\_\_\_\_

SCALE \_\_\_\_\_

DRAWN BY \_\_\_\_\_

DATE \_\_\_\_\_

DRAWING NO. \_\_\_\_\_  
OFFICE SPACE



**AS-BUILT EXAMPLES**

NOT TO SCALE

NO. ISSUE/REVISION DATE


PROJECT \_\_\_\_\_

SCALE \_\_\_\_\_

DRAWN BY \_\_\_\_\_

DATE \_\_\_\_\_

DRAWING NO. \_\_\_\_\_  
**OFFICE SPACE**

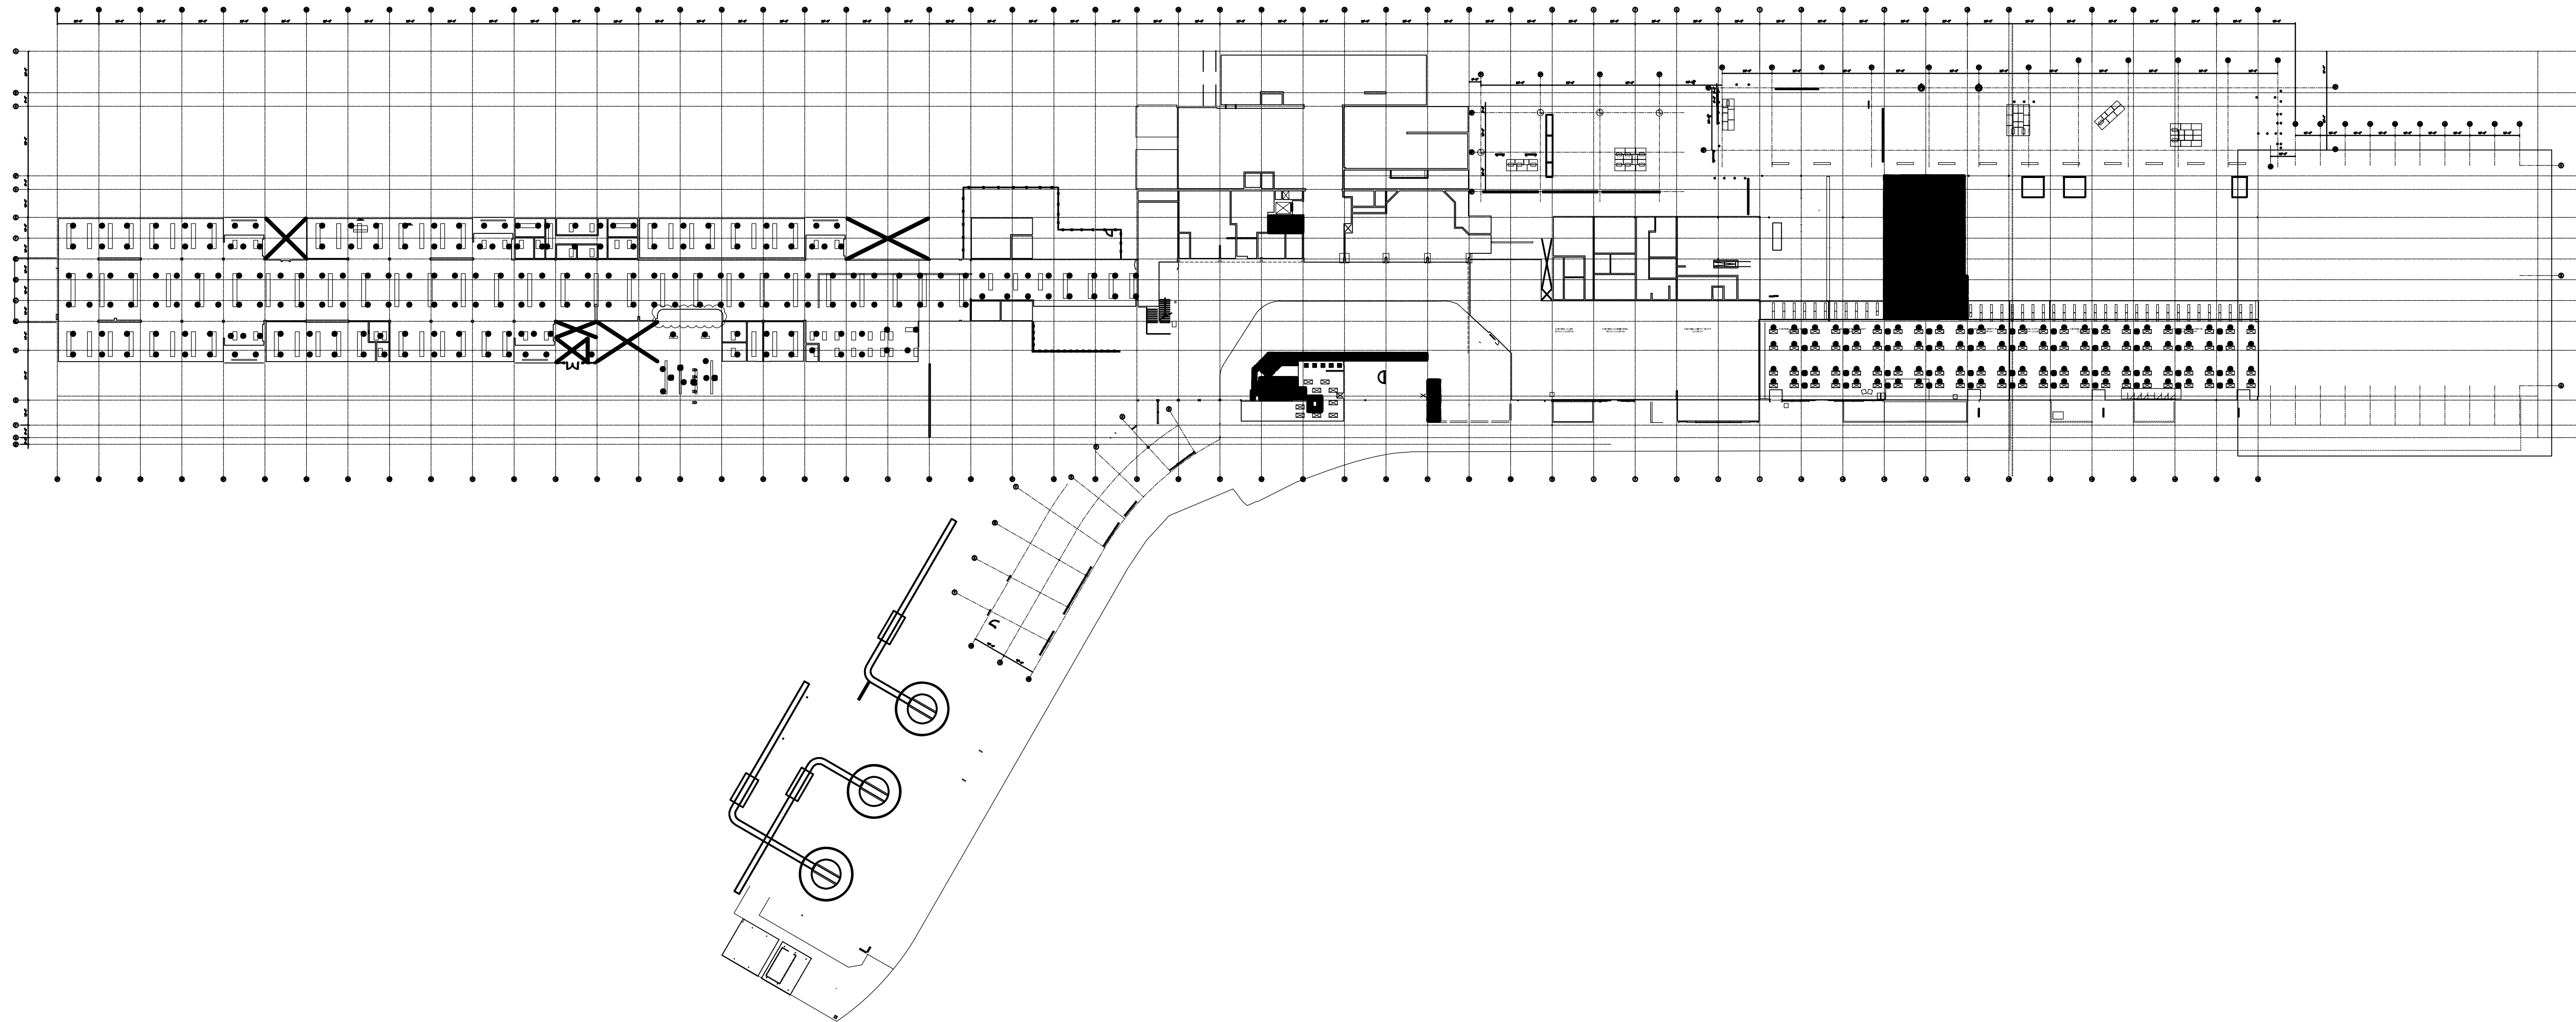

**AS-BUILT EXAMPLES**

NOT TO SCALE

| NO. | ISSUE/REVISION | DATE |
|-----|----------------|------|
|-----|----------------|------|

PROJECT \_\_\_\_\_

SCALE \_\_\_\_\_

DRAWN BY \_\_\_\_\_

DATE \_\_\_\_\_

DRAWING NO.  
**OFFICE SPACE**

**A1.7**