

AS-BUILT EXAMPLES

NOT TO SCALE

NO. ISSUE/REVISION DATE

PROJECT _____



SCALE _____

DRAWN BY _____

DATE _____

DRAWING NO. _____
SPECIALTY PROJECTS

A2.0

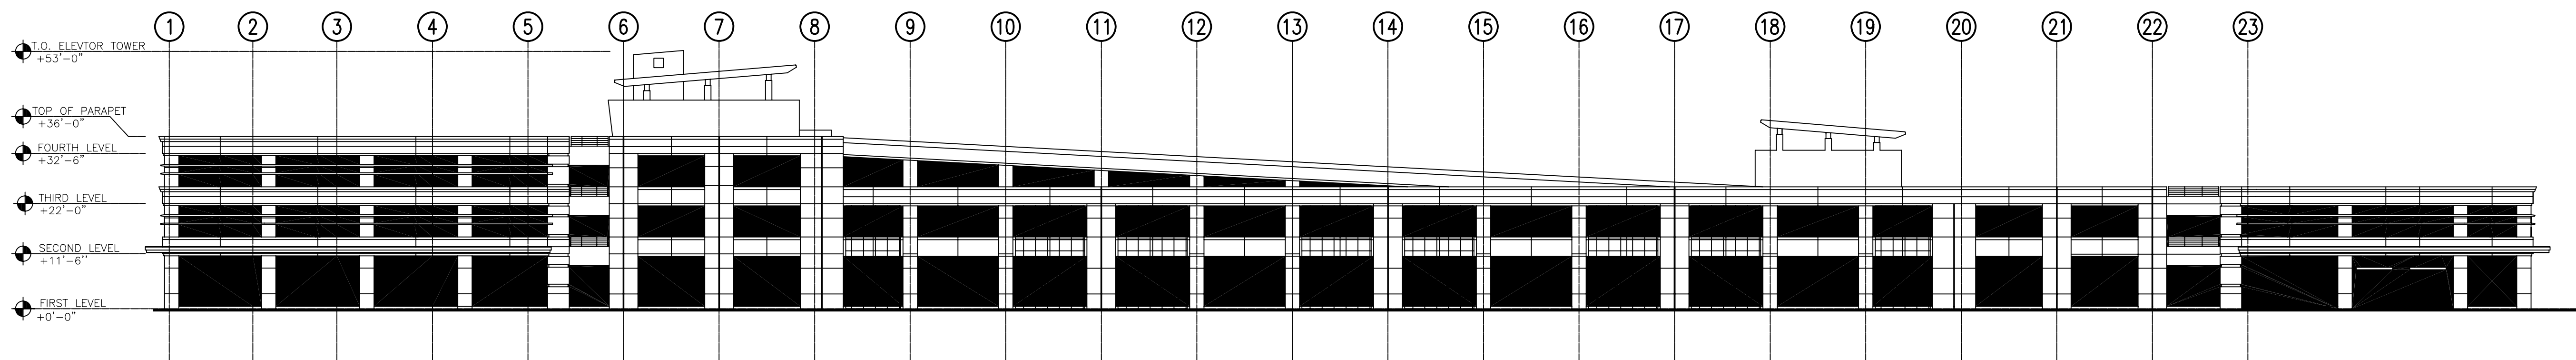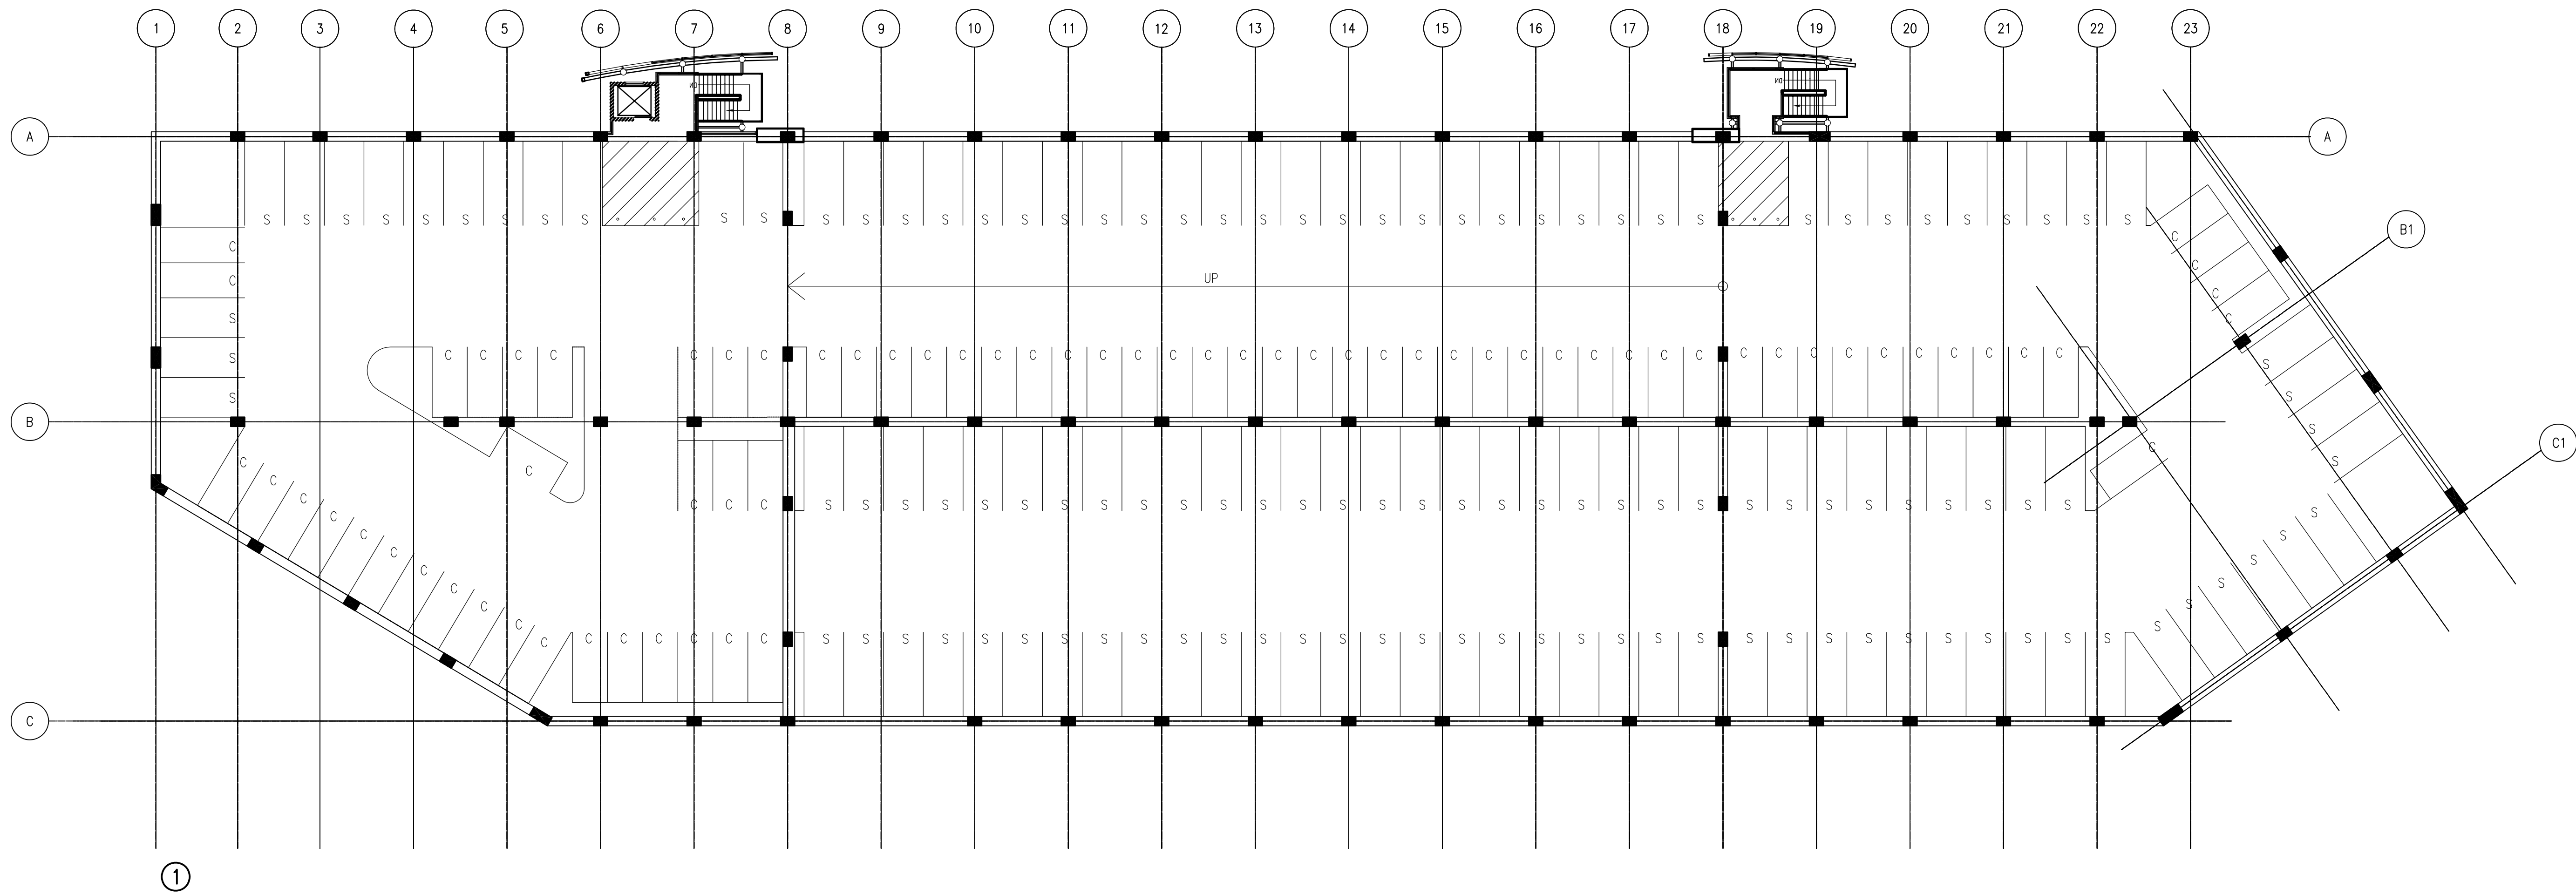

AS-BUILT EXAMPLES

NOT TO SCALE

NO. ISSUE/REVISION DATE

PROJECT _____


SCALE _____

DRAWN BY _____

DATE _____

DRAWING NO. SPECIALTY PROJECTS

A2.1

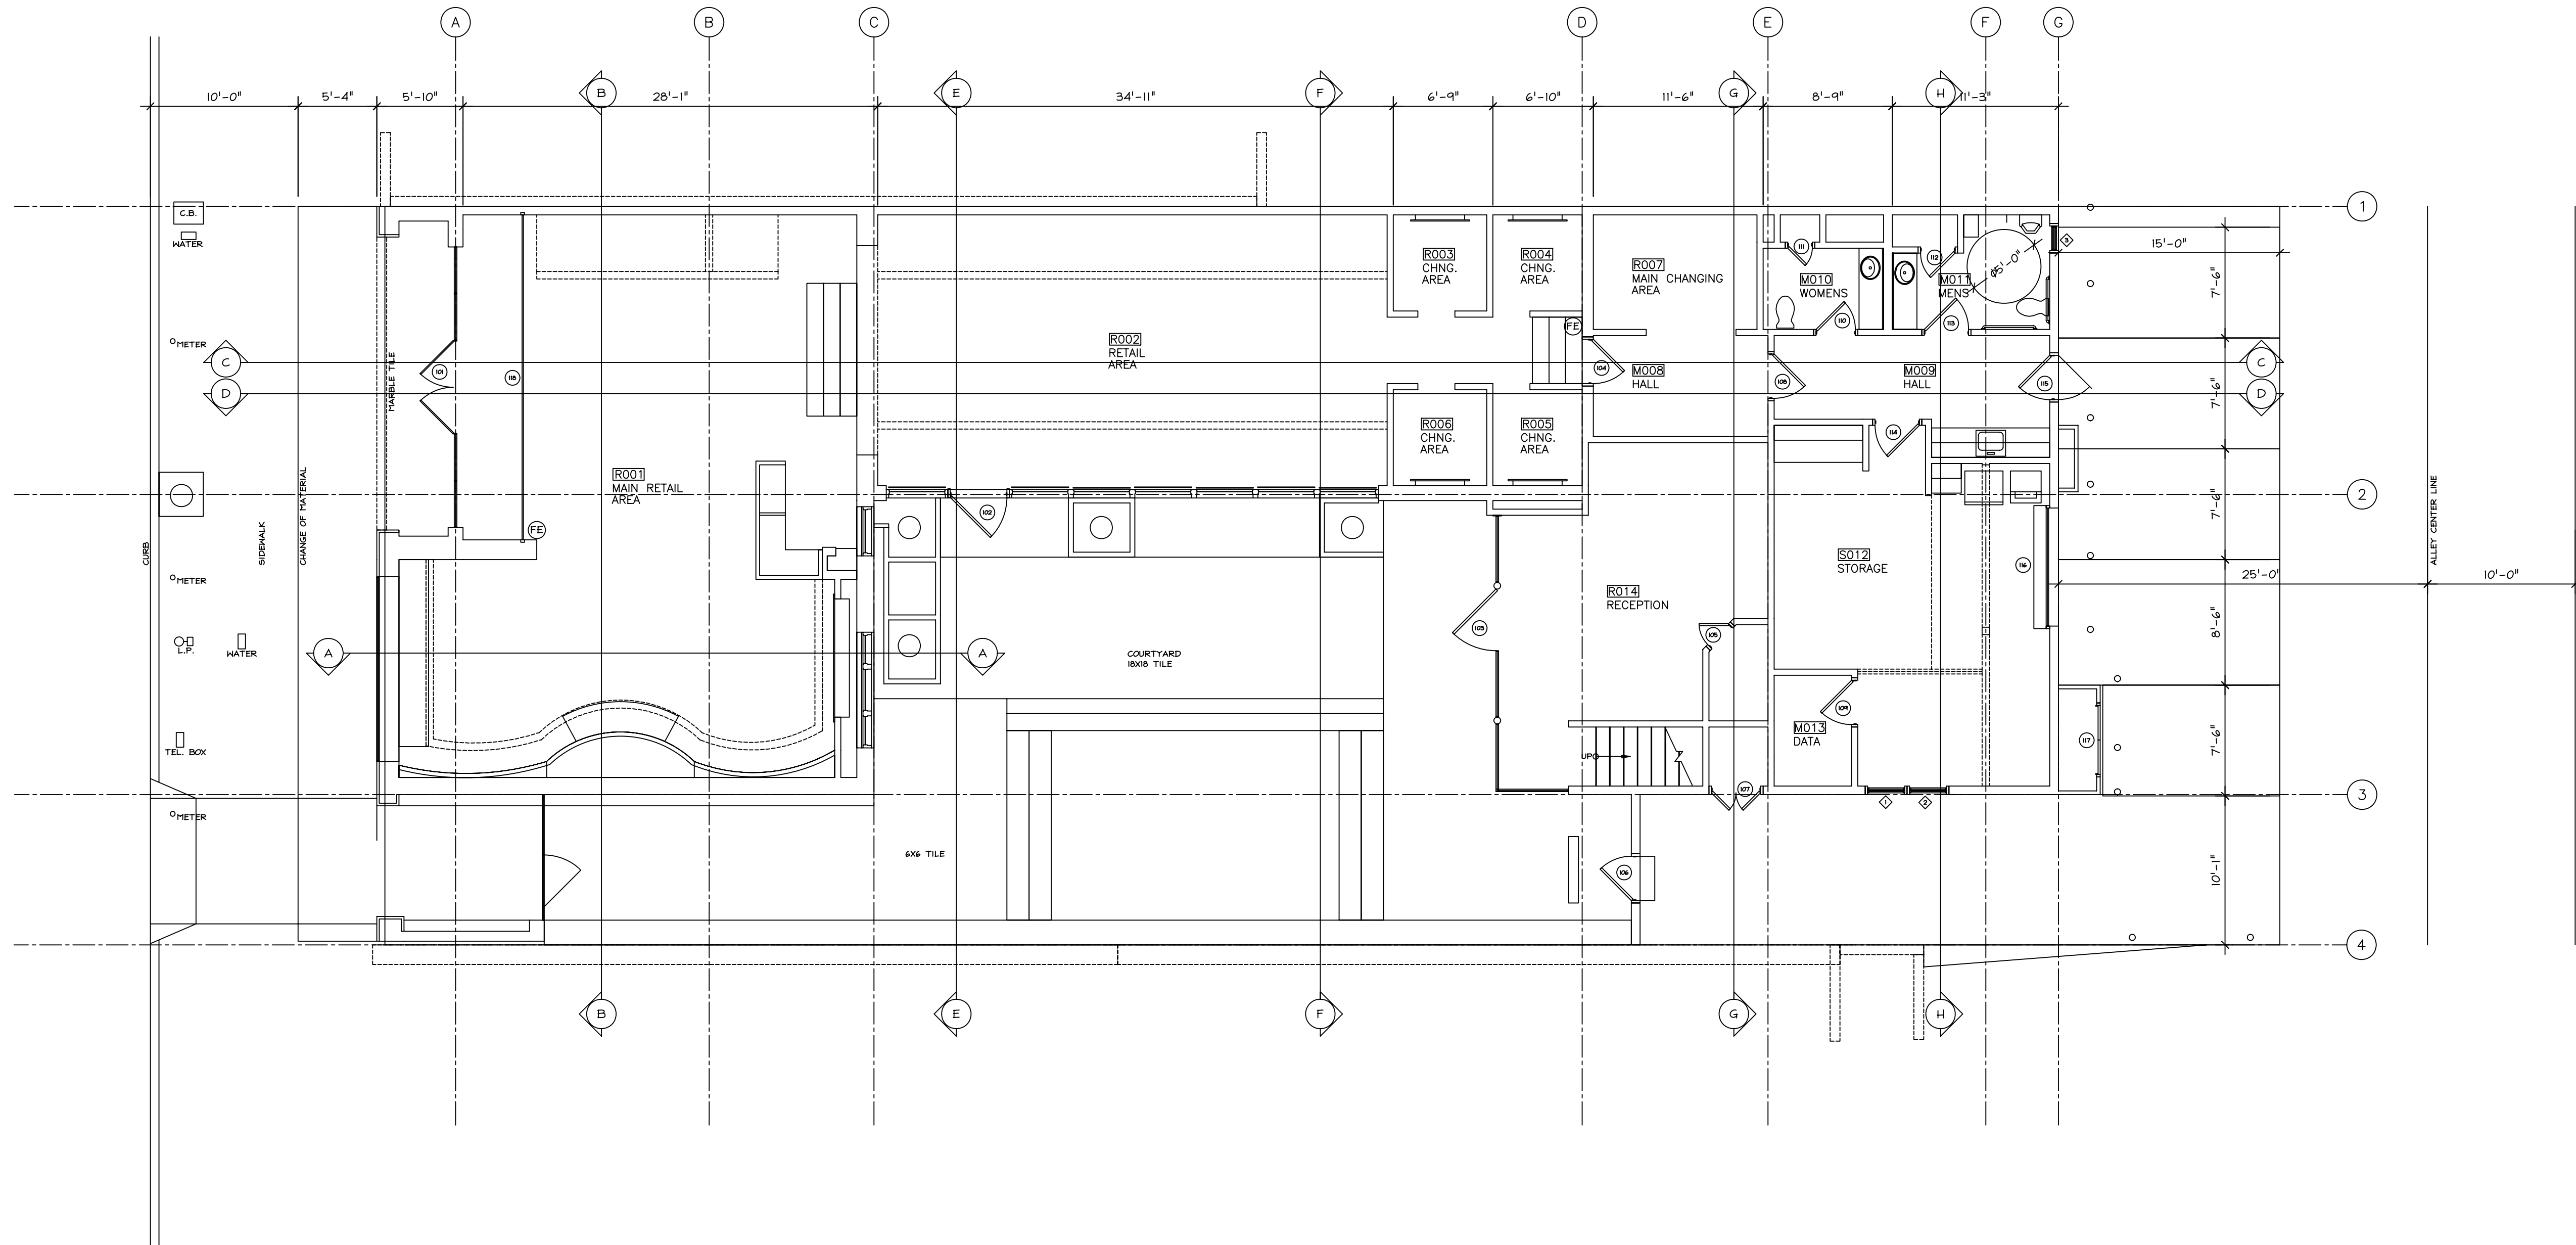

AS-BUILT EXAMPLES
NOT TO SCALE

NO. ISSUE/REVISION DATE

PROJECT _____


SCALE _____

DRAWN BY _____

DATE _____

DRAWING NO.
SPECIALTY PROJECTS

A2.2

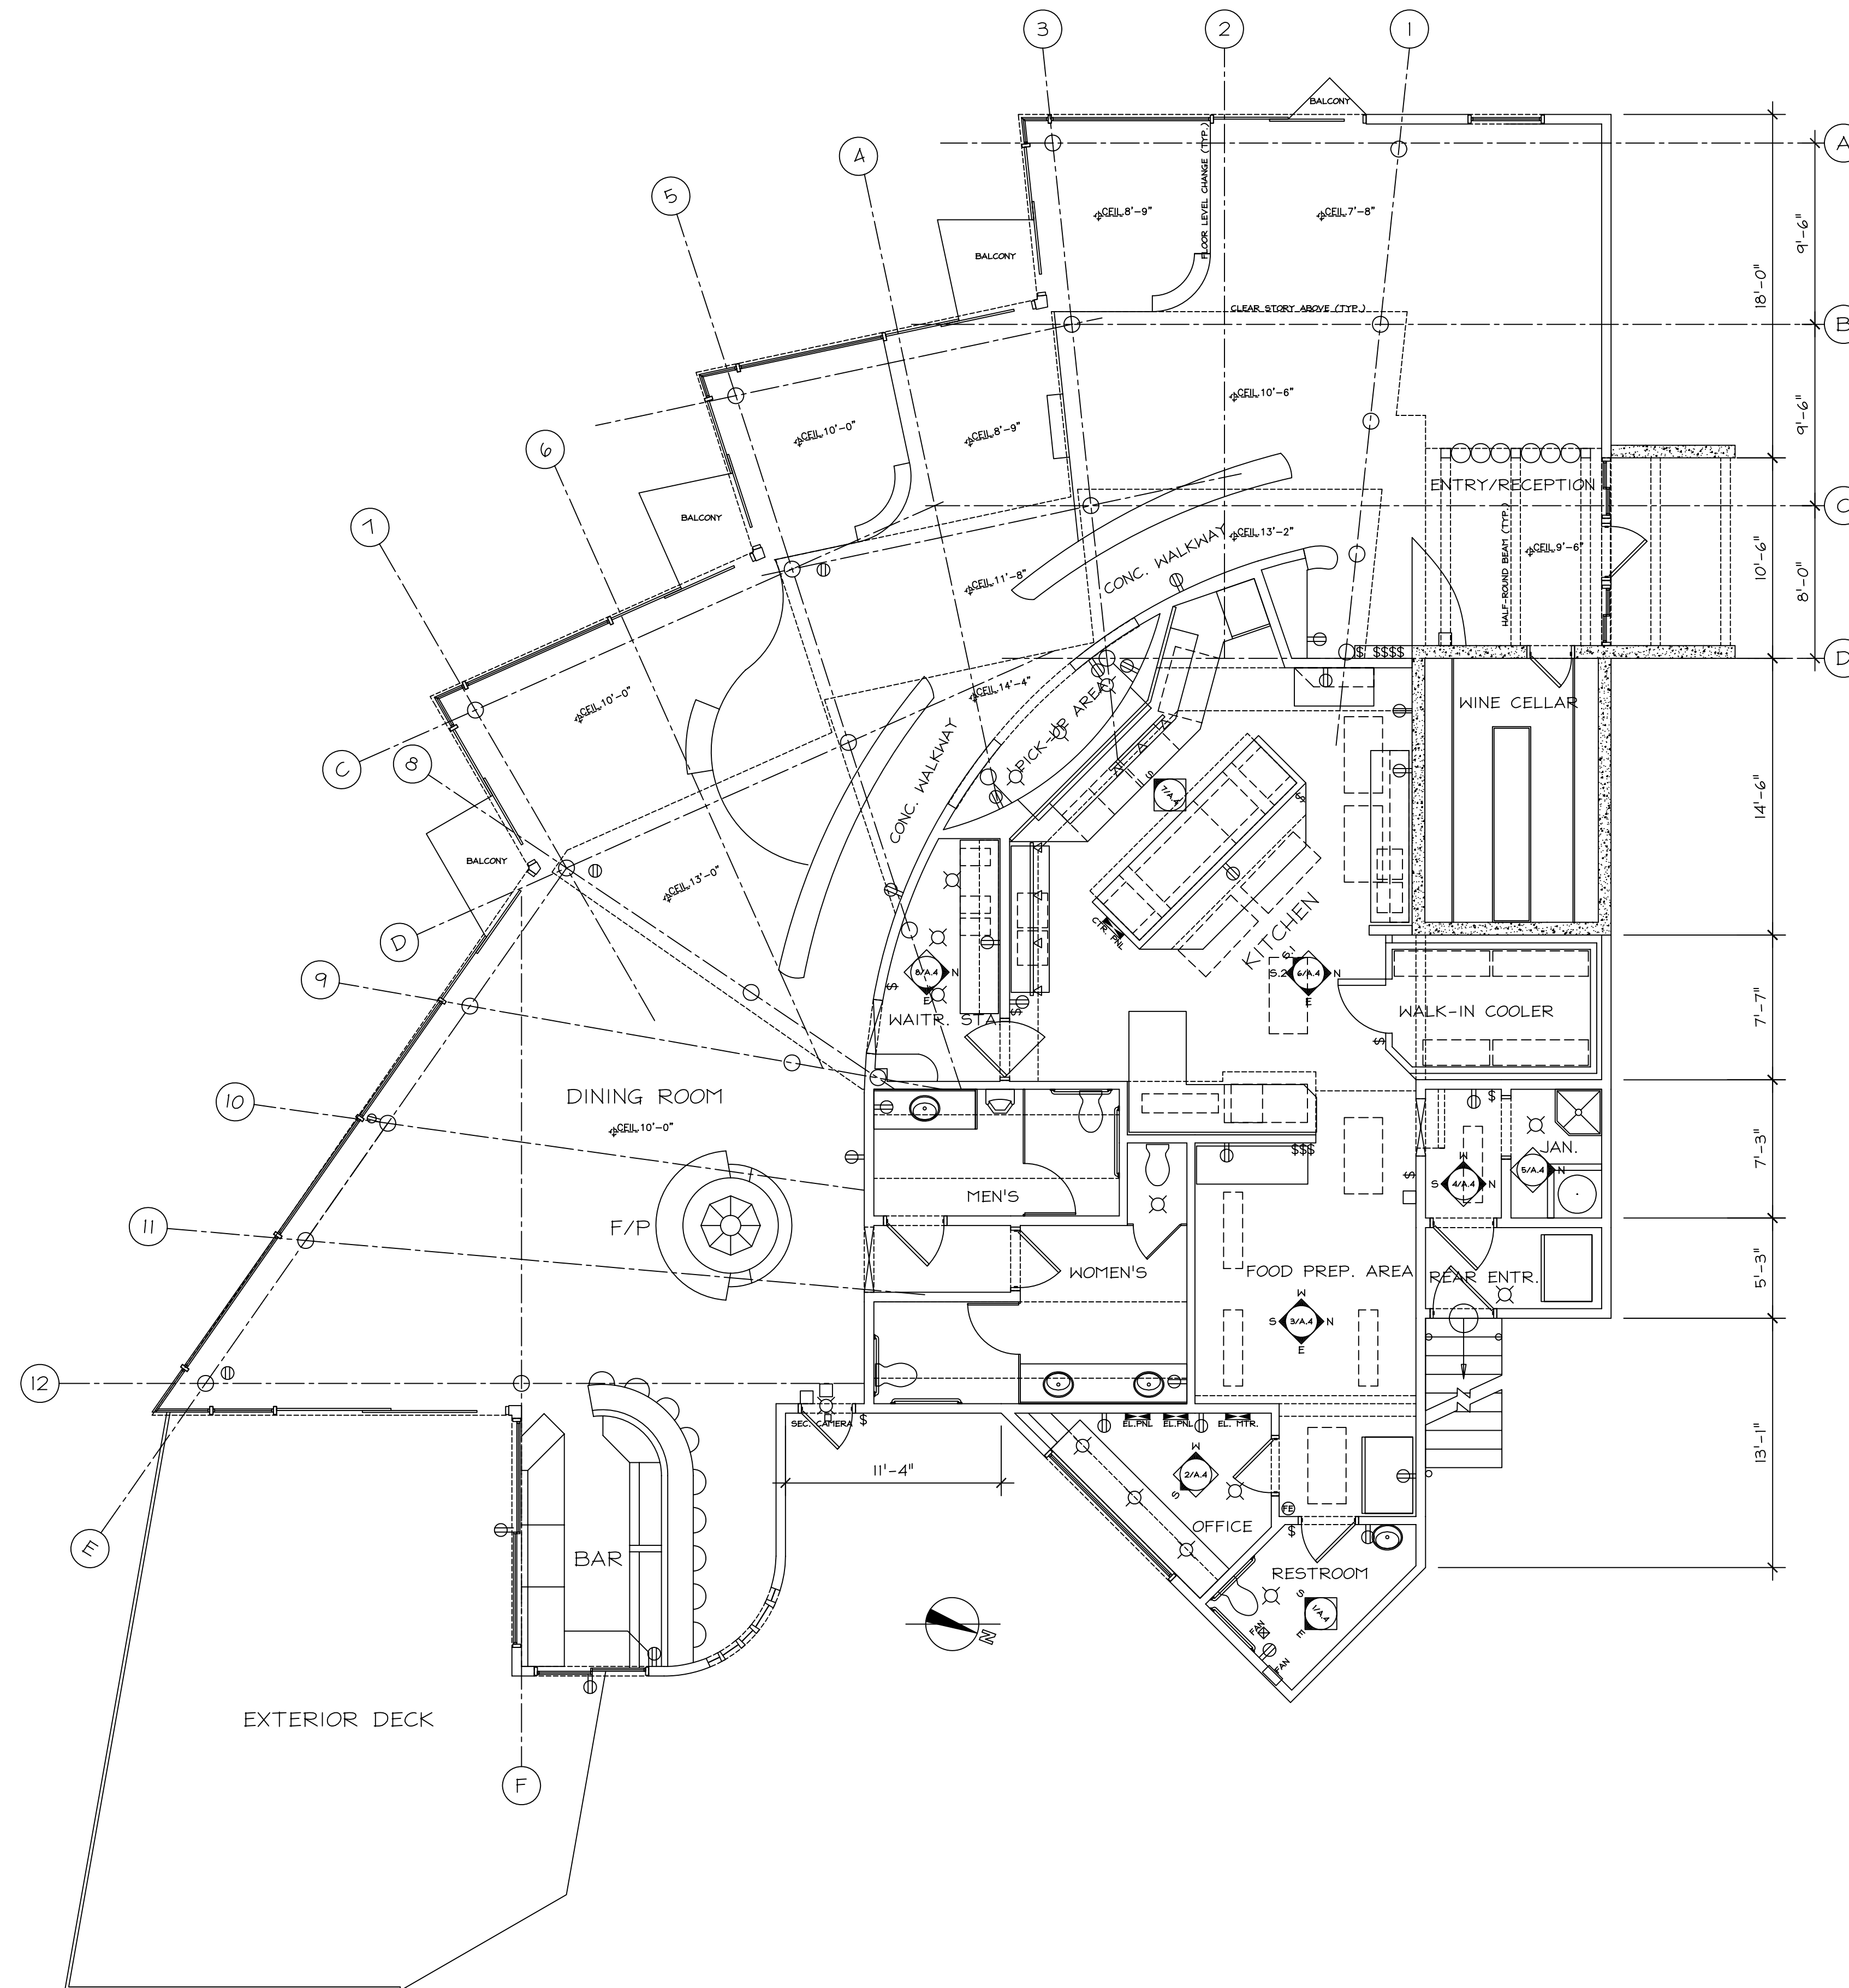

AS-BUILT EXAMPLES

NOT TO SCALE

NO.	ISSUE/REVISION	DATE


PROJECT _____

SCALE _____

DRAWN BY _____

DATE _____

DRAWING NO. SPECIALTY PROJECTS

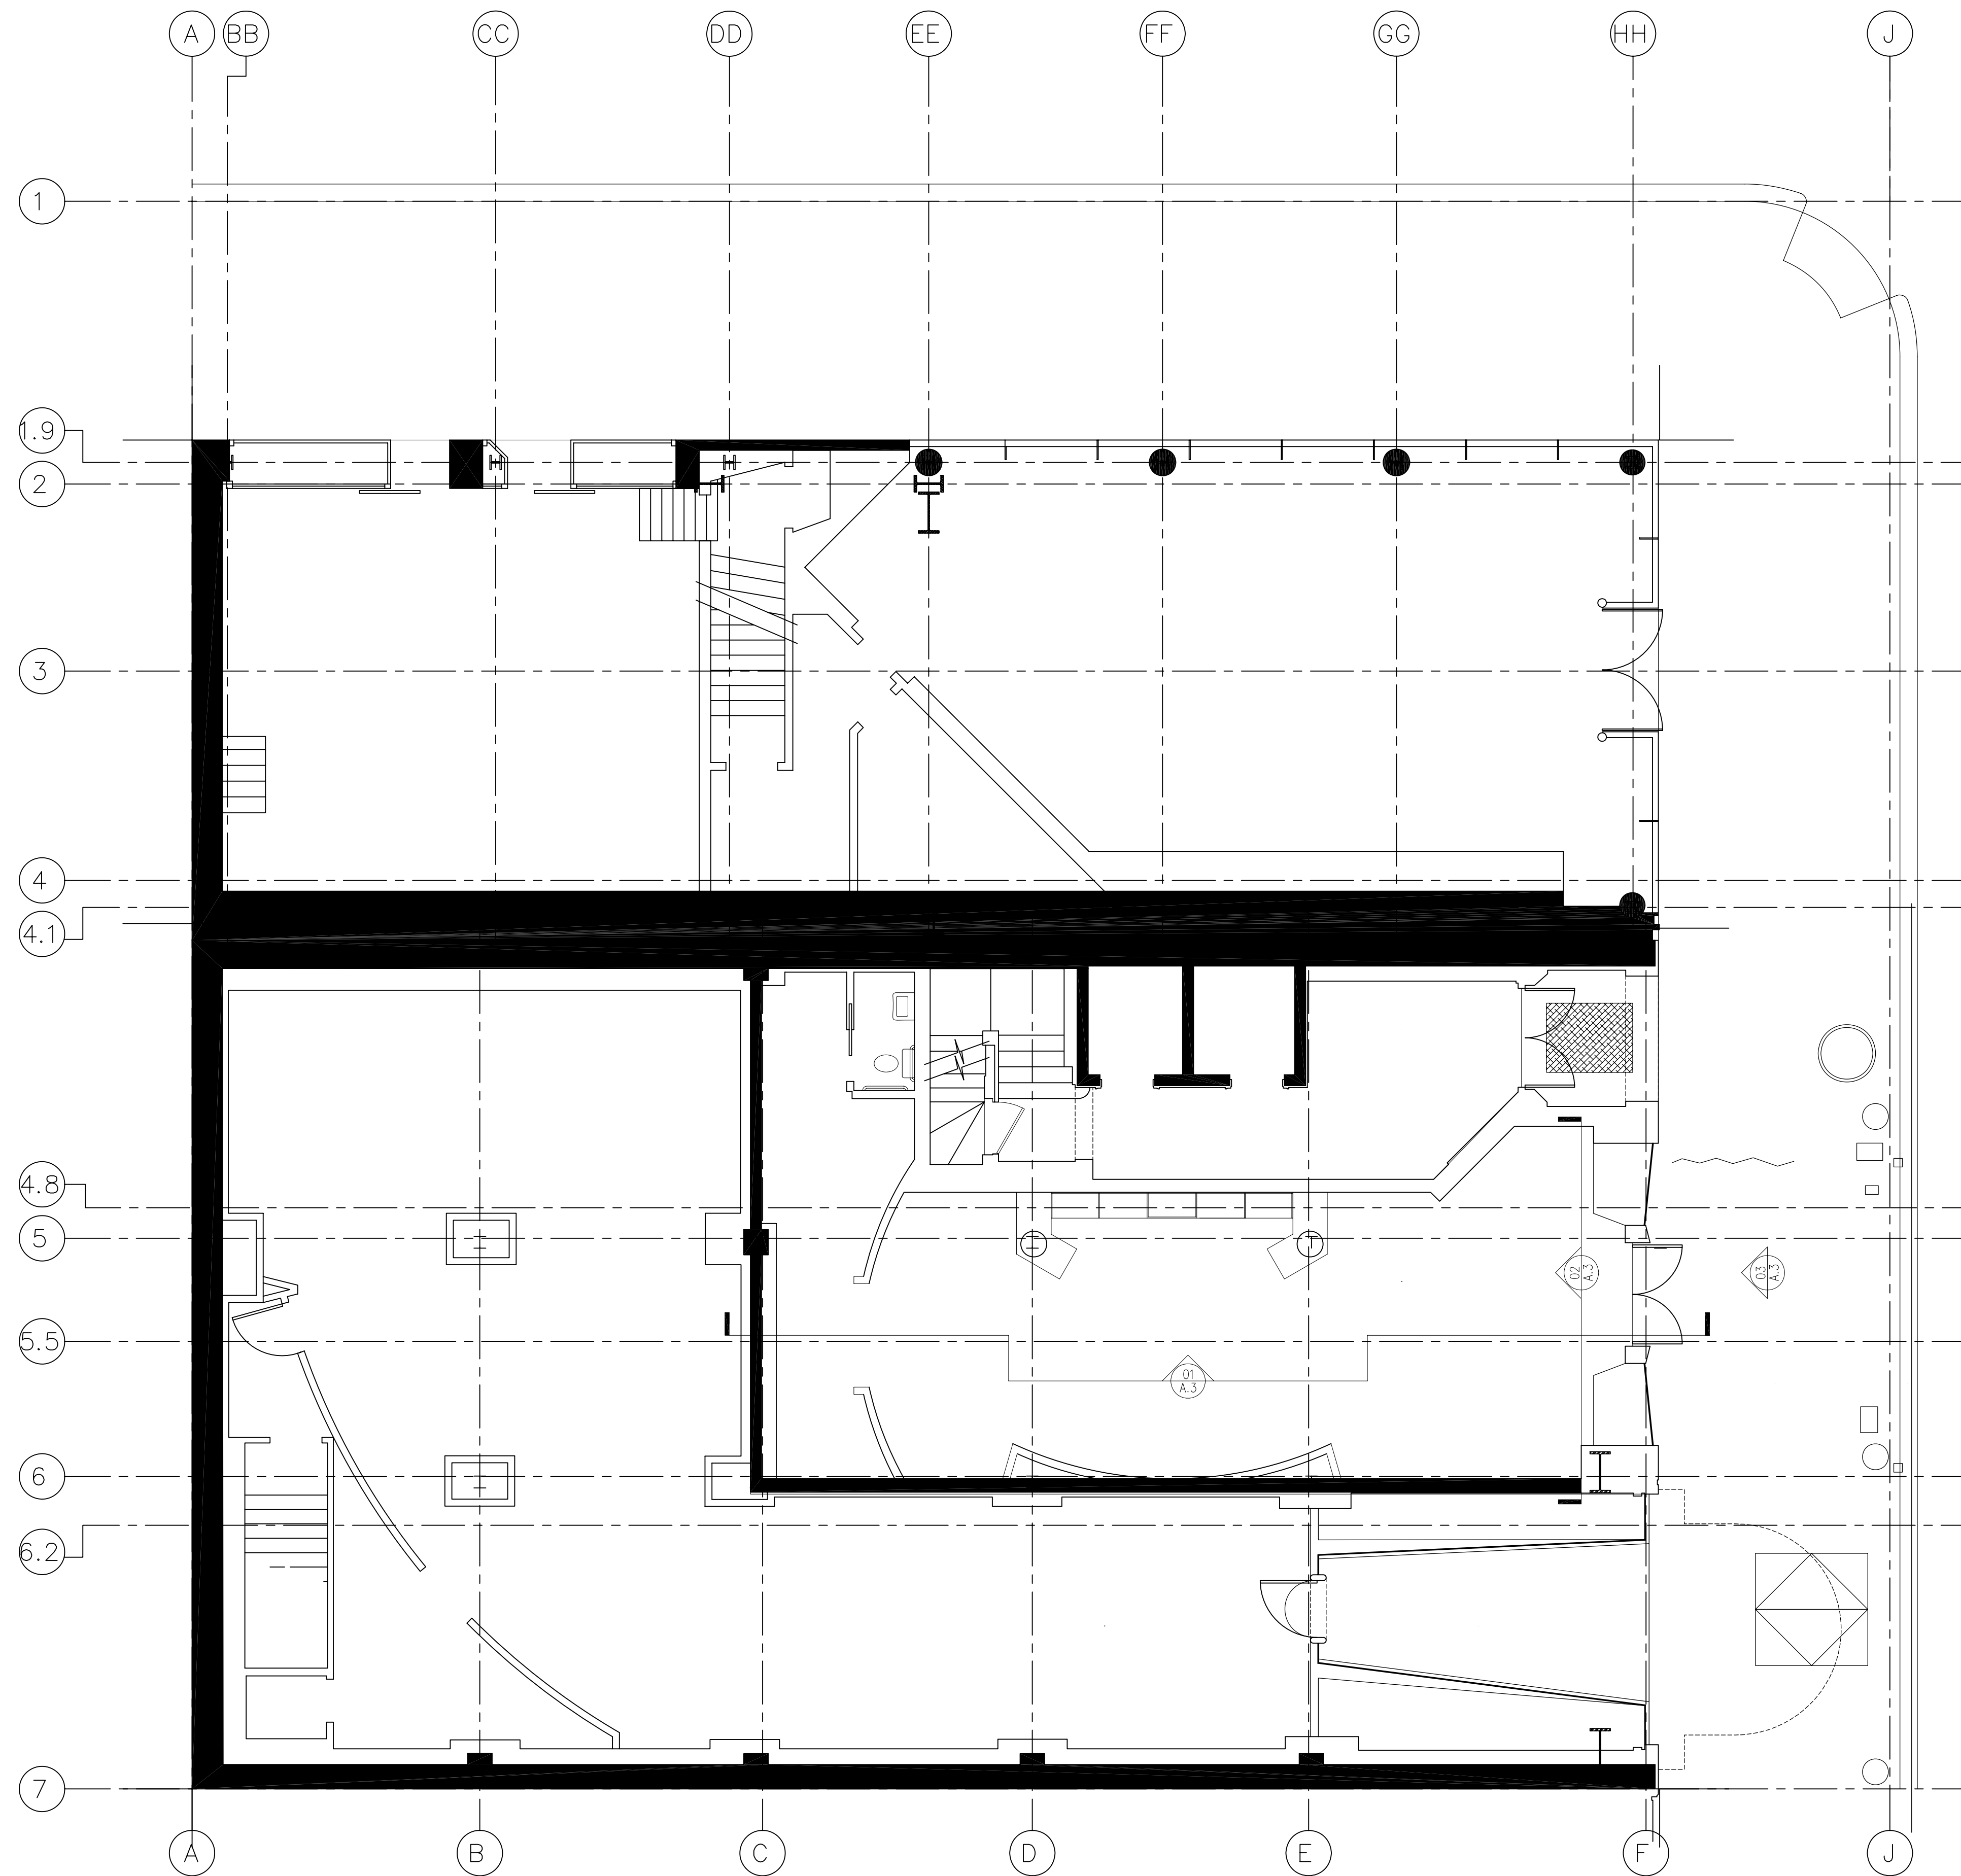

AS-BUILT EXAMPLES

NOT TO SCALE

NO. ISSUE/REVISION DATE


PROJECT _____

SCALE _____

DRAWN BY _____

DATE _____

DRAWING NO. _____
SPECIALTY PROJECTS

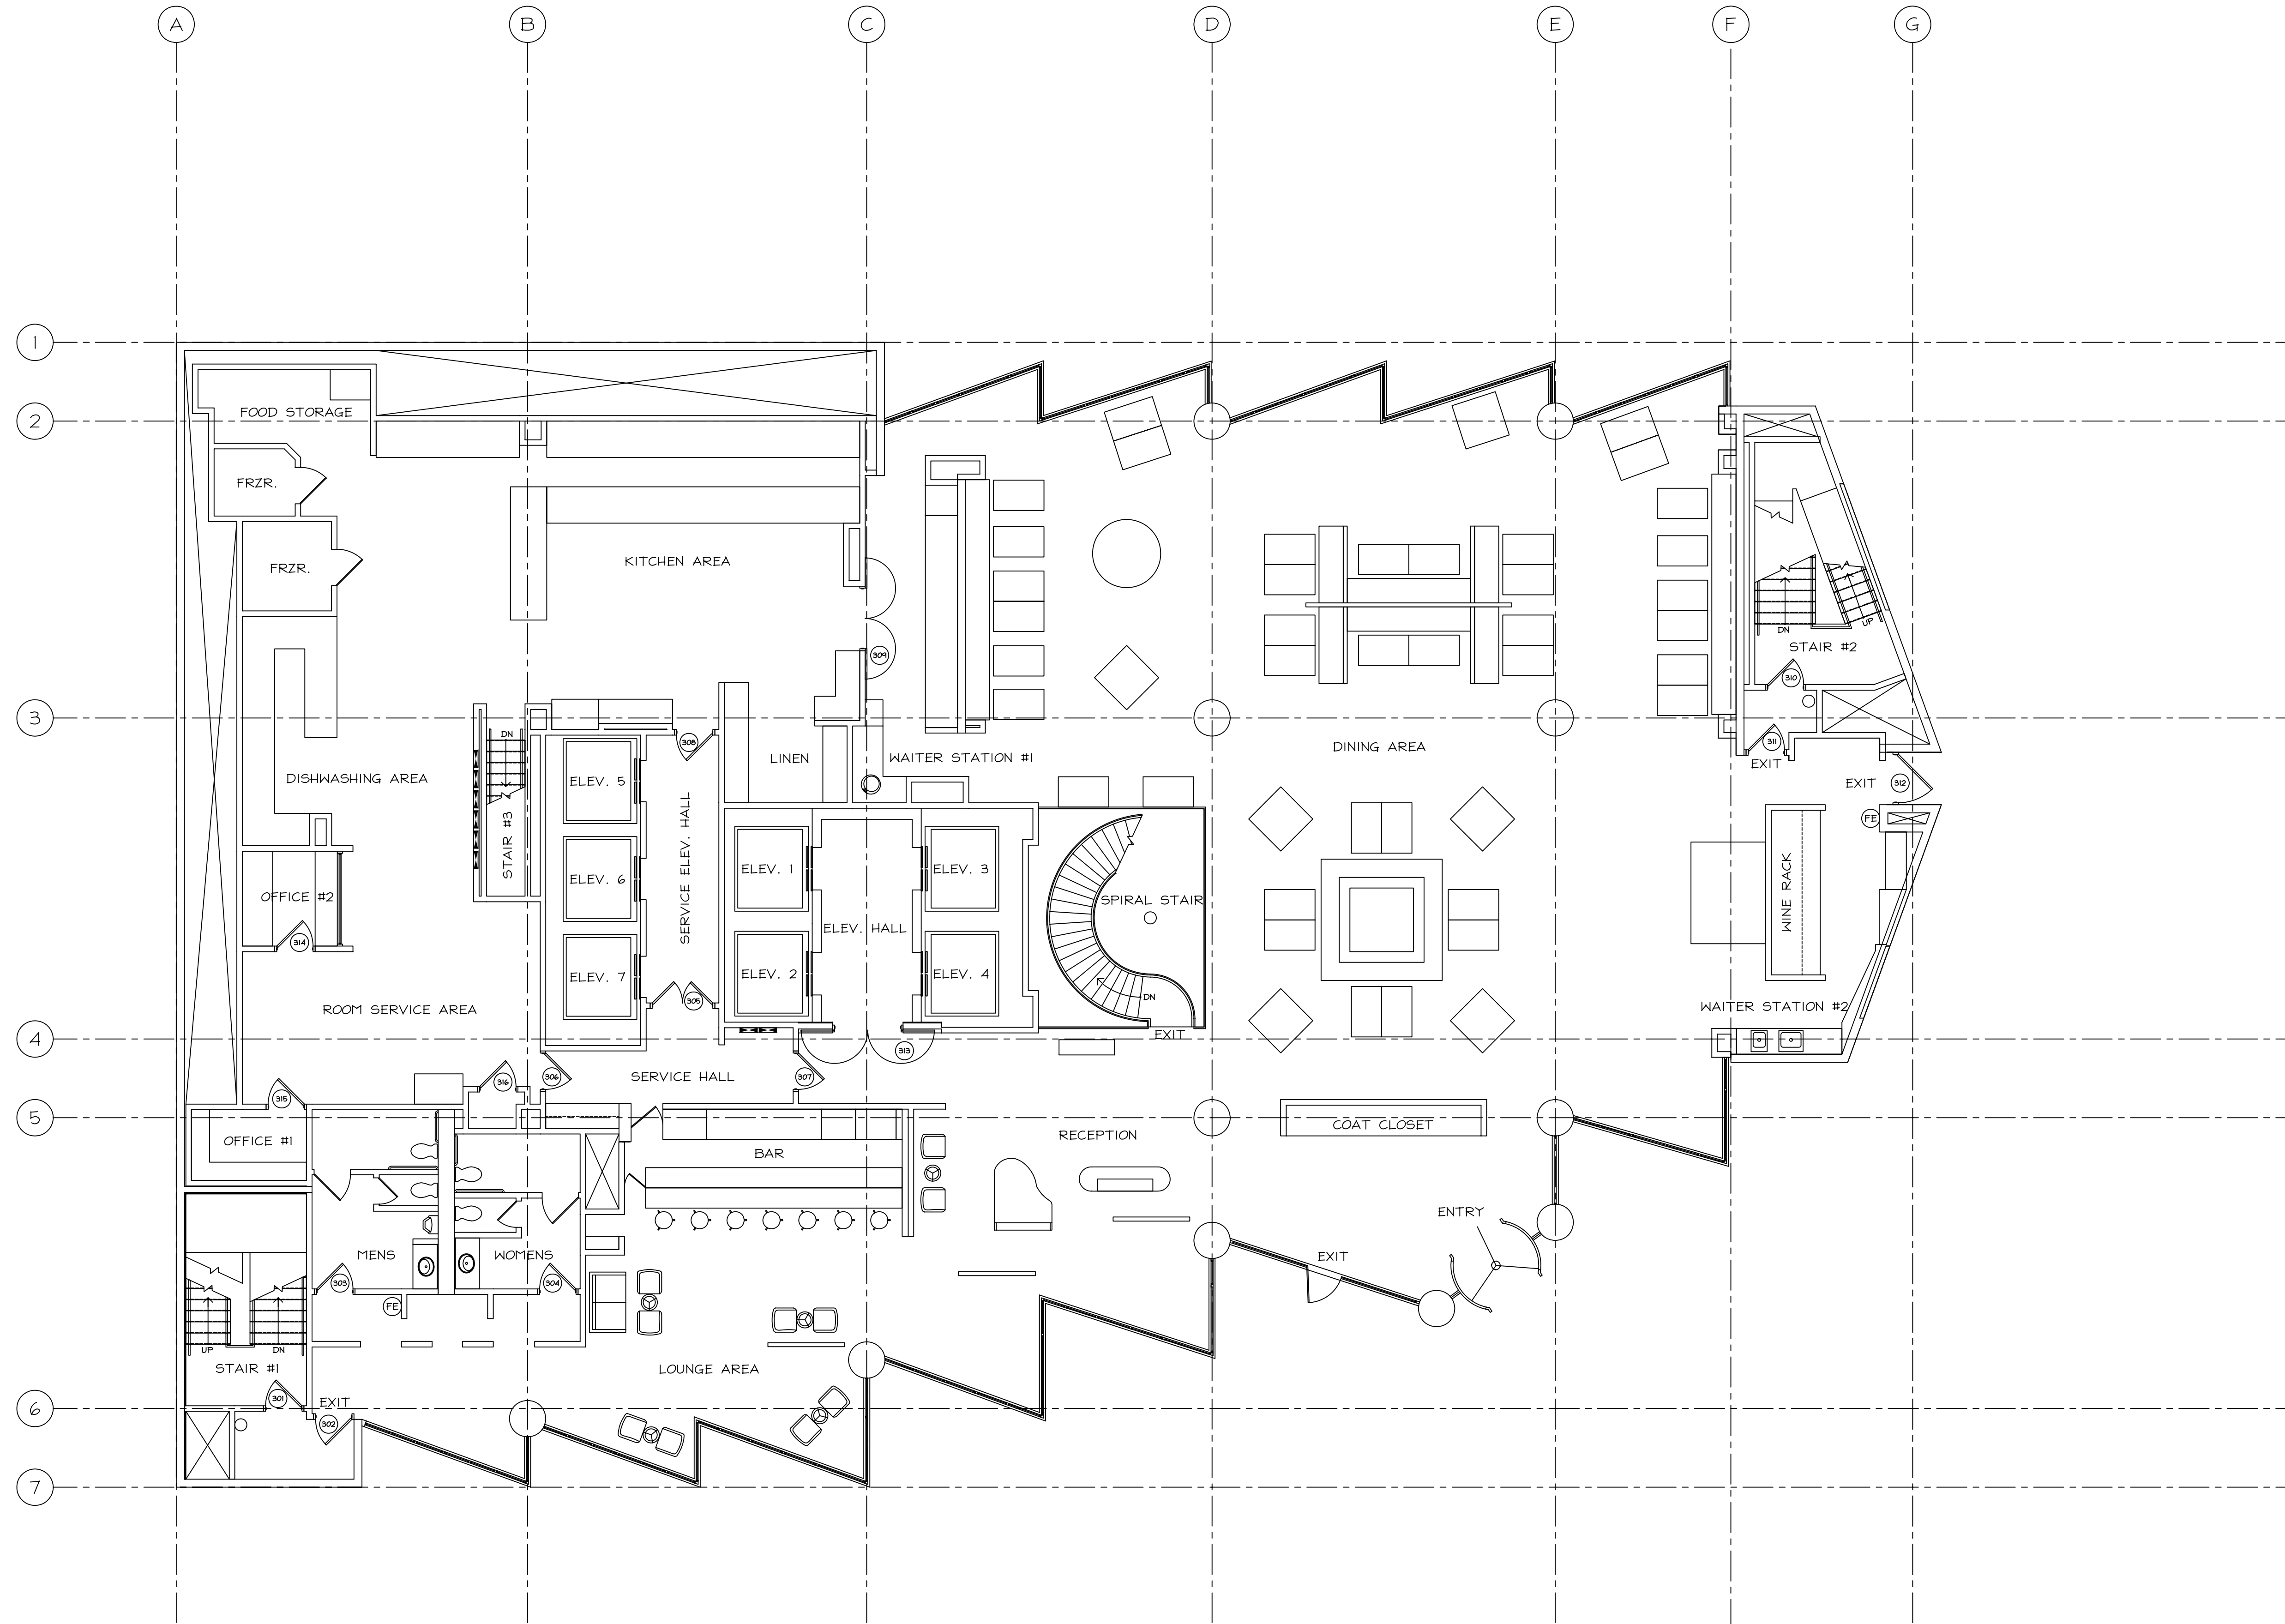

AS-BUILT EXAMPLES

NOT TO SCALE

NO. ISSUE/REVISION DATE


PROJECT _____

SCALE _____

DRAWN BY _____

DATE _____

DRAWING NO. _____
SPECIALTY PROJECTS

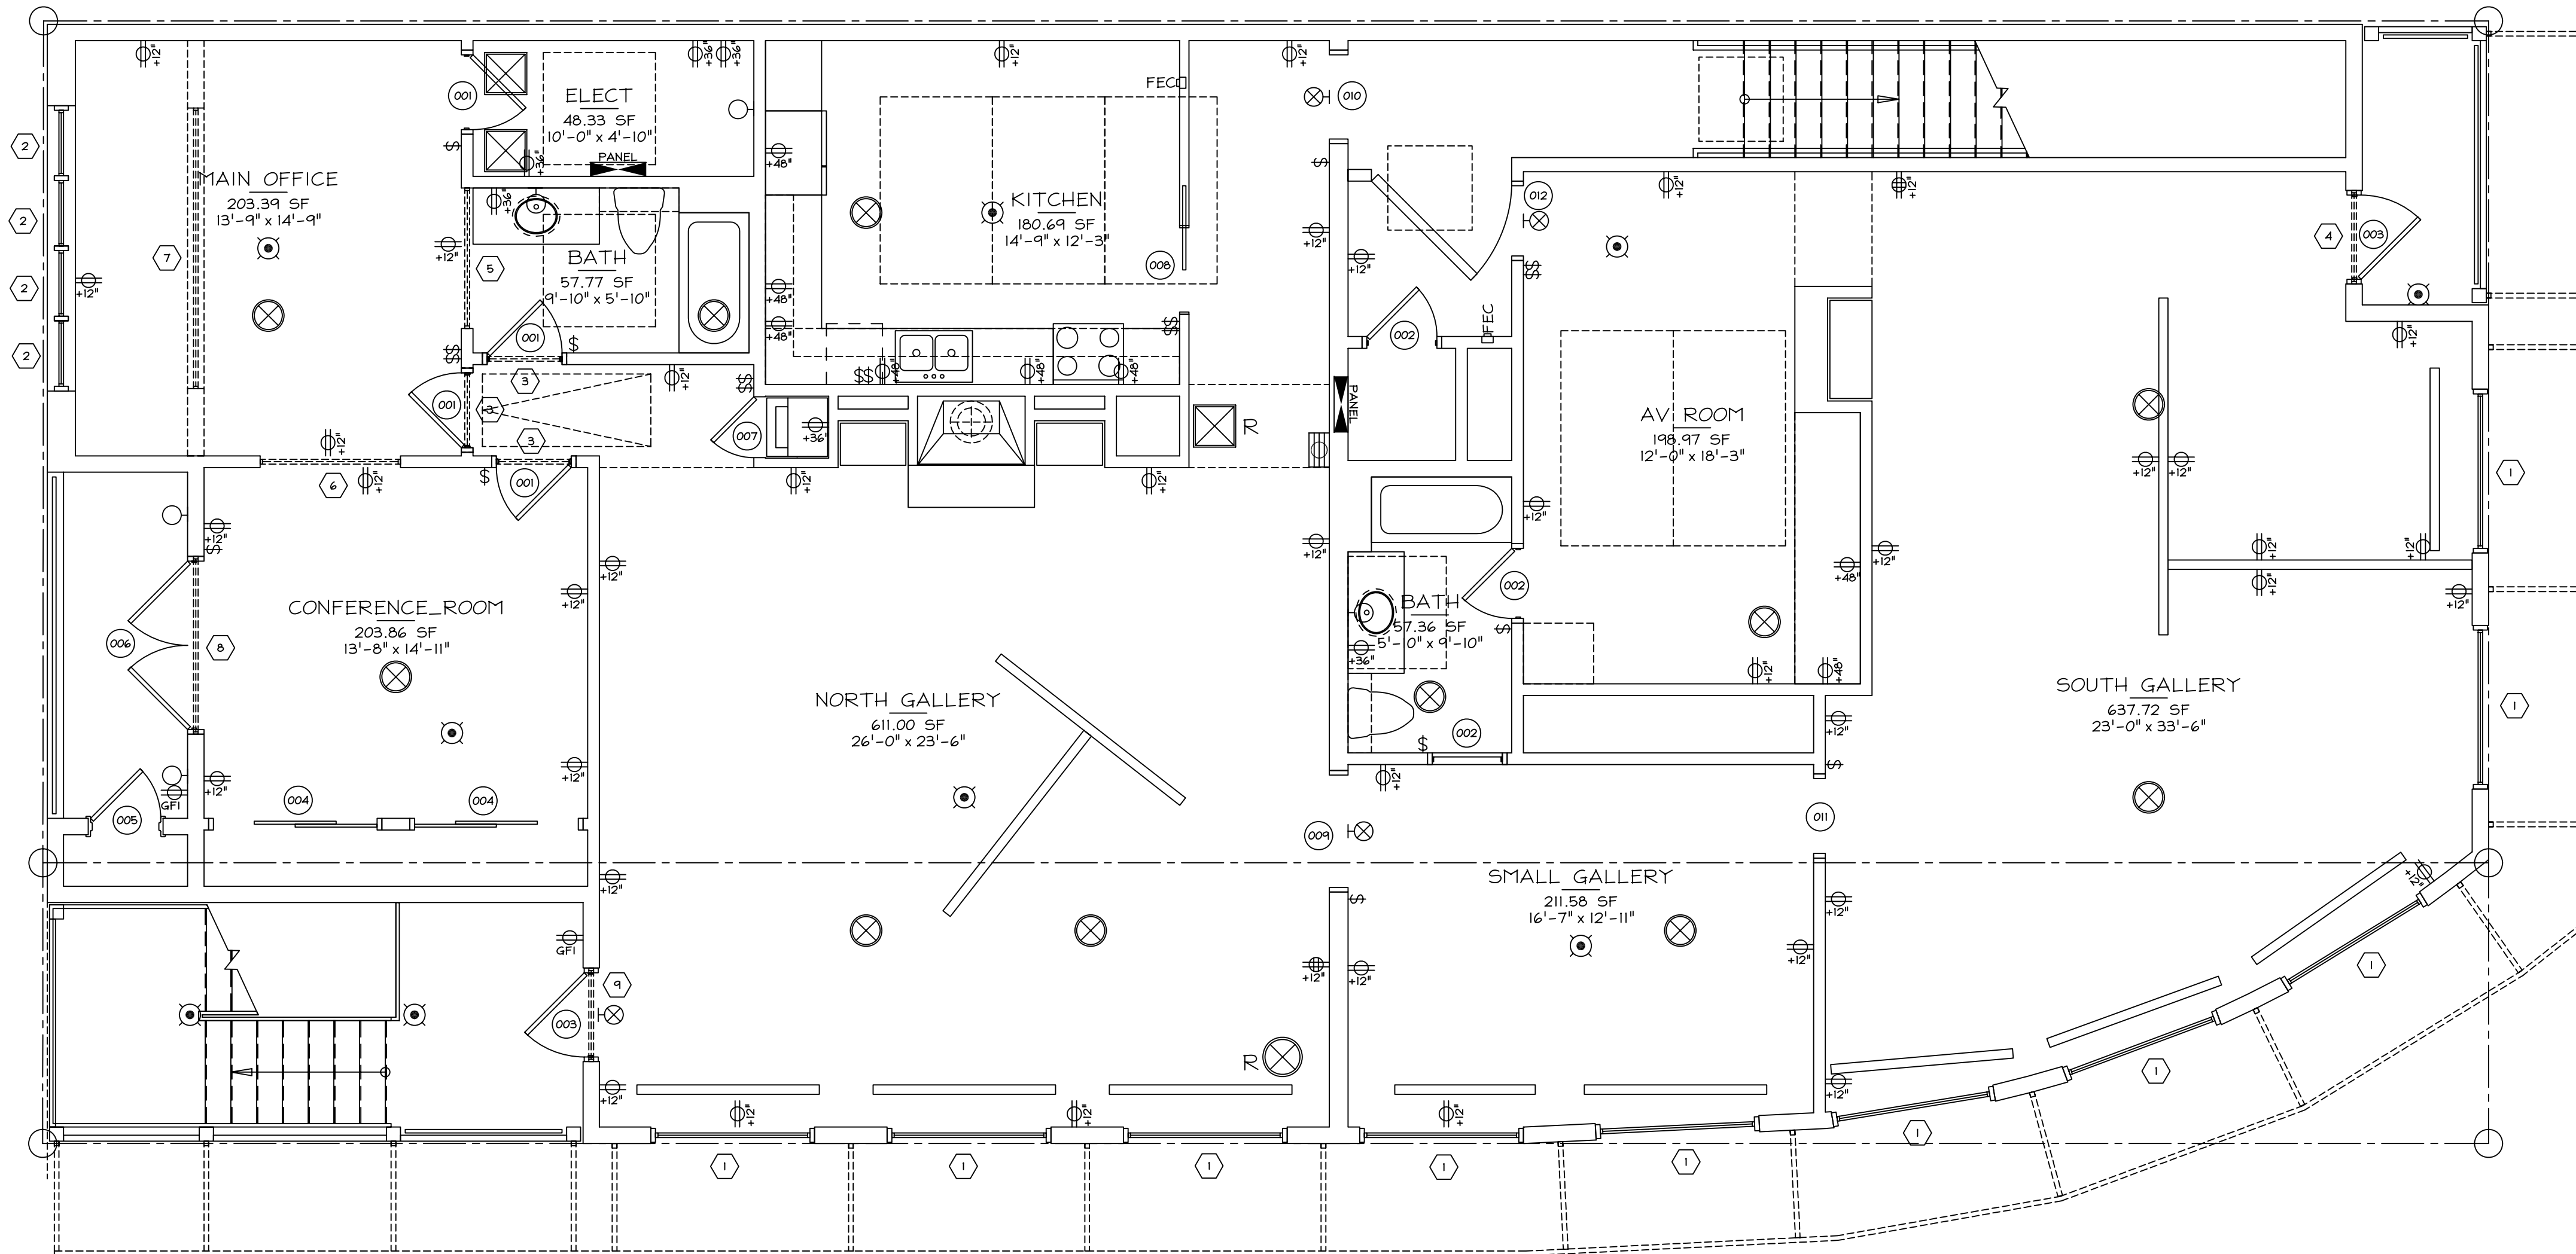

AS-BUILT EXAMPLES
NOT TO SCALE

NO.	ISSUE/REVISION	DATE
-----	----------------	------

PROJECT _____

SCALE _____

DRAWN BY _____

DATE _____

DRAWING NO. _____
SPECIALTY PROJECTS