

AS-BUILT EXAMPLES

NOT TO SCALE

NO. ISSUE/REVISION DATE


PROJECT _____

SCALE _____

DRAWN BY _____

DATE _____

DRAWING NO. _____
OFFICE SPACE

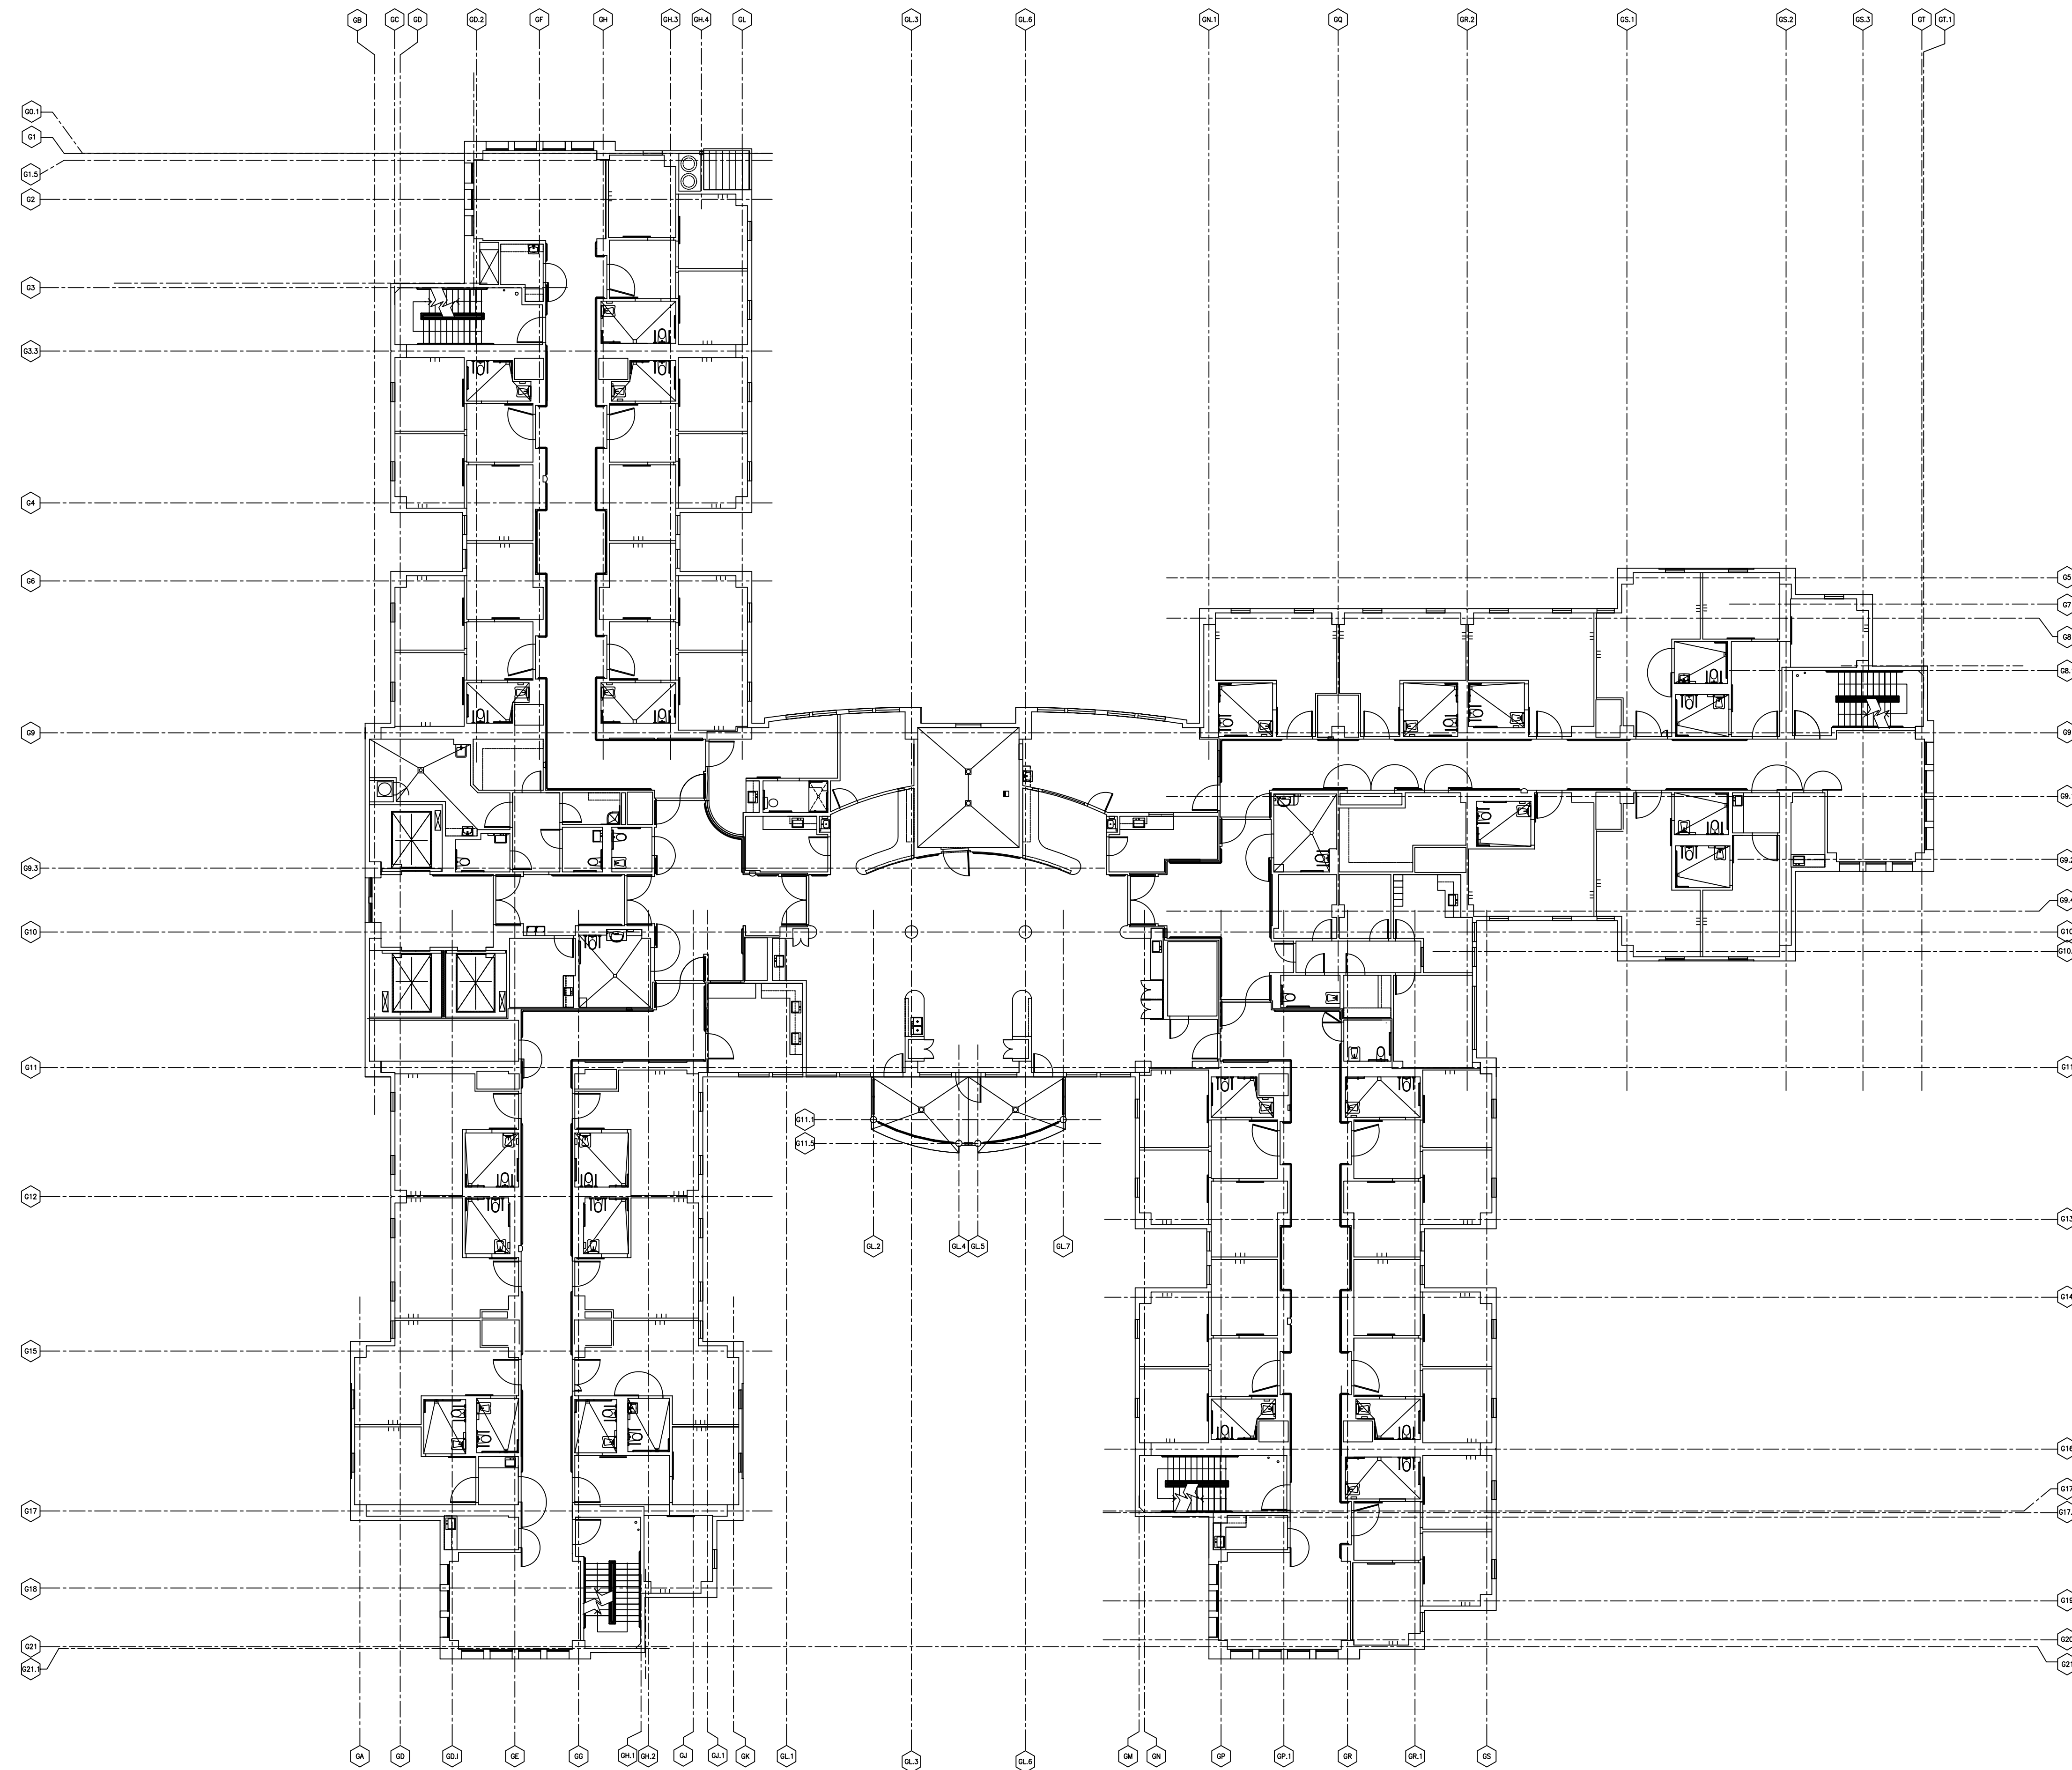

AS-BUILT EXAMPLES

NOT TO SCALE

NO. ISSUE/REVISION DATE


PROJECT _____

SCALE _____

DRAWN BY _____

DATE _____

DRAWING NO.
OFFICE SPACE

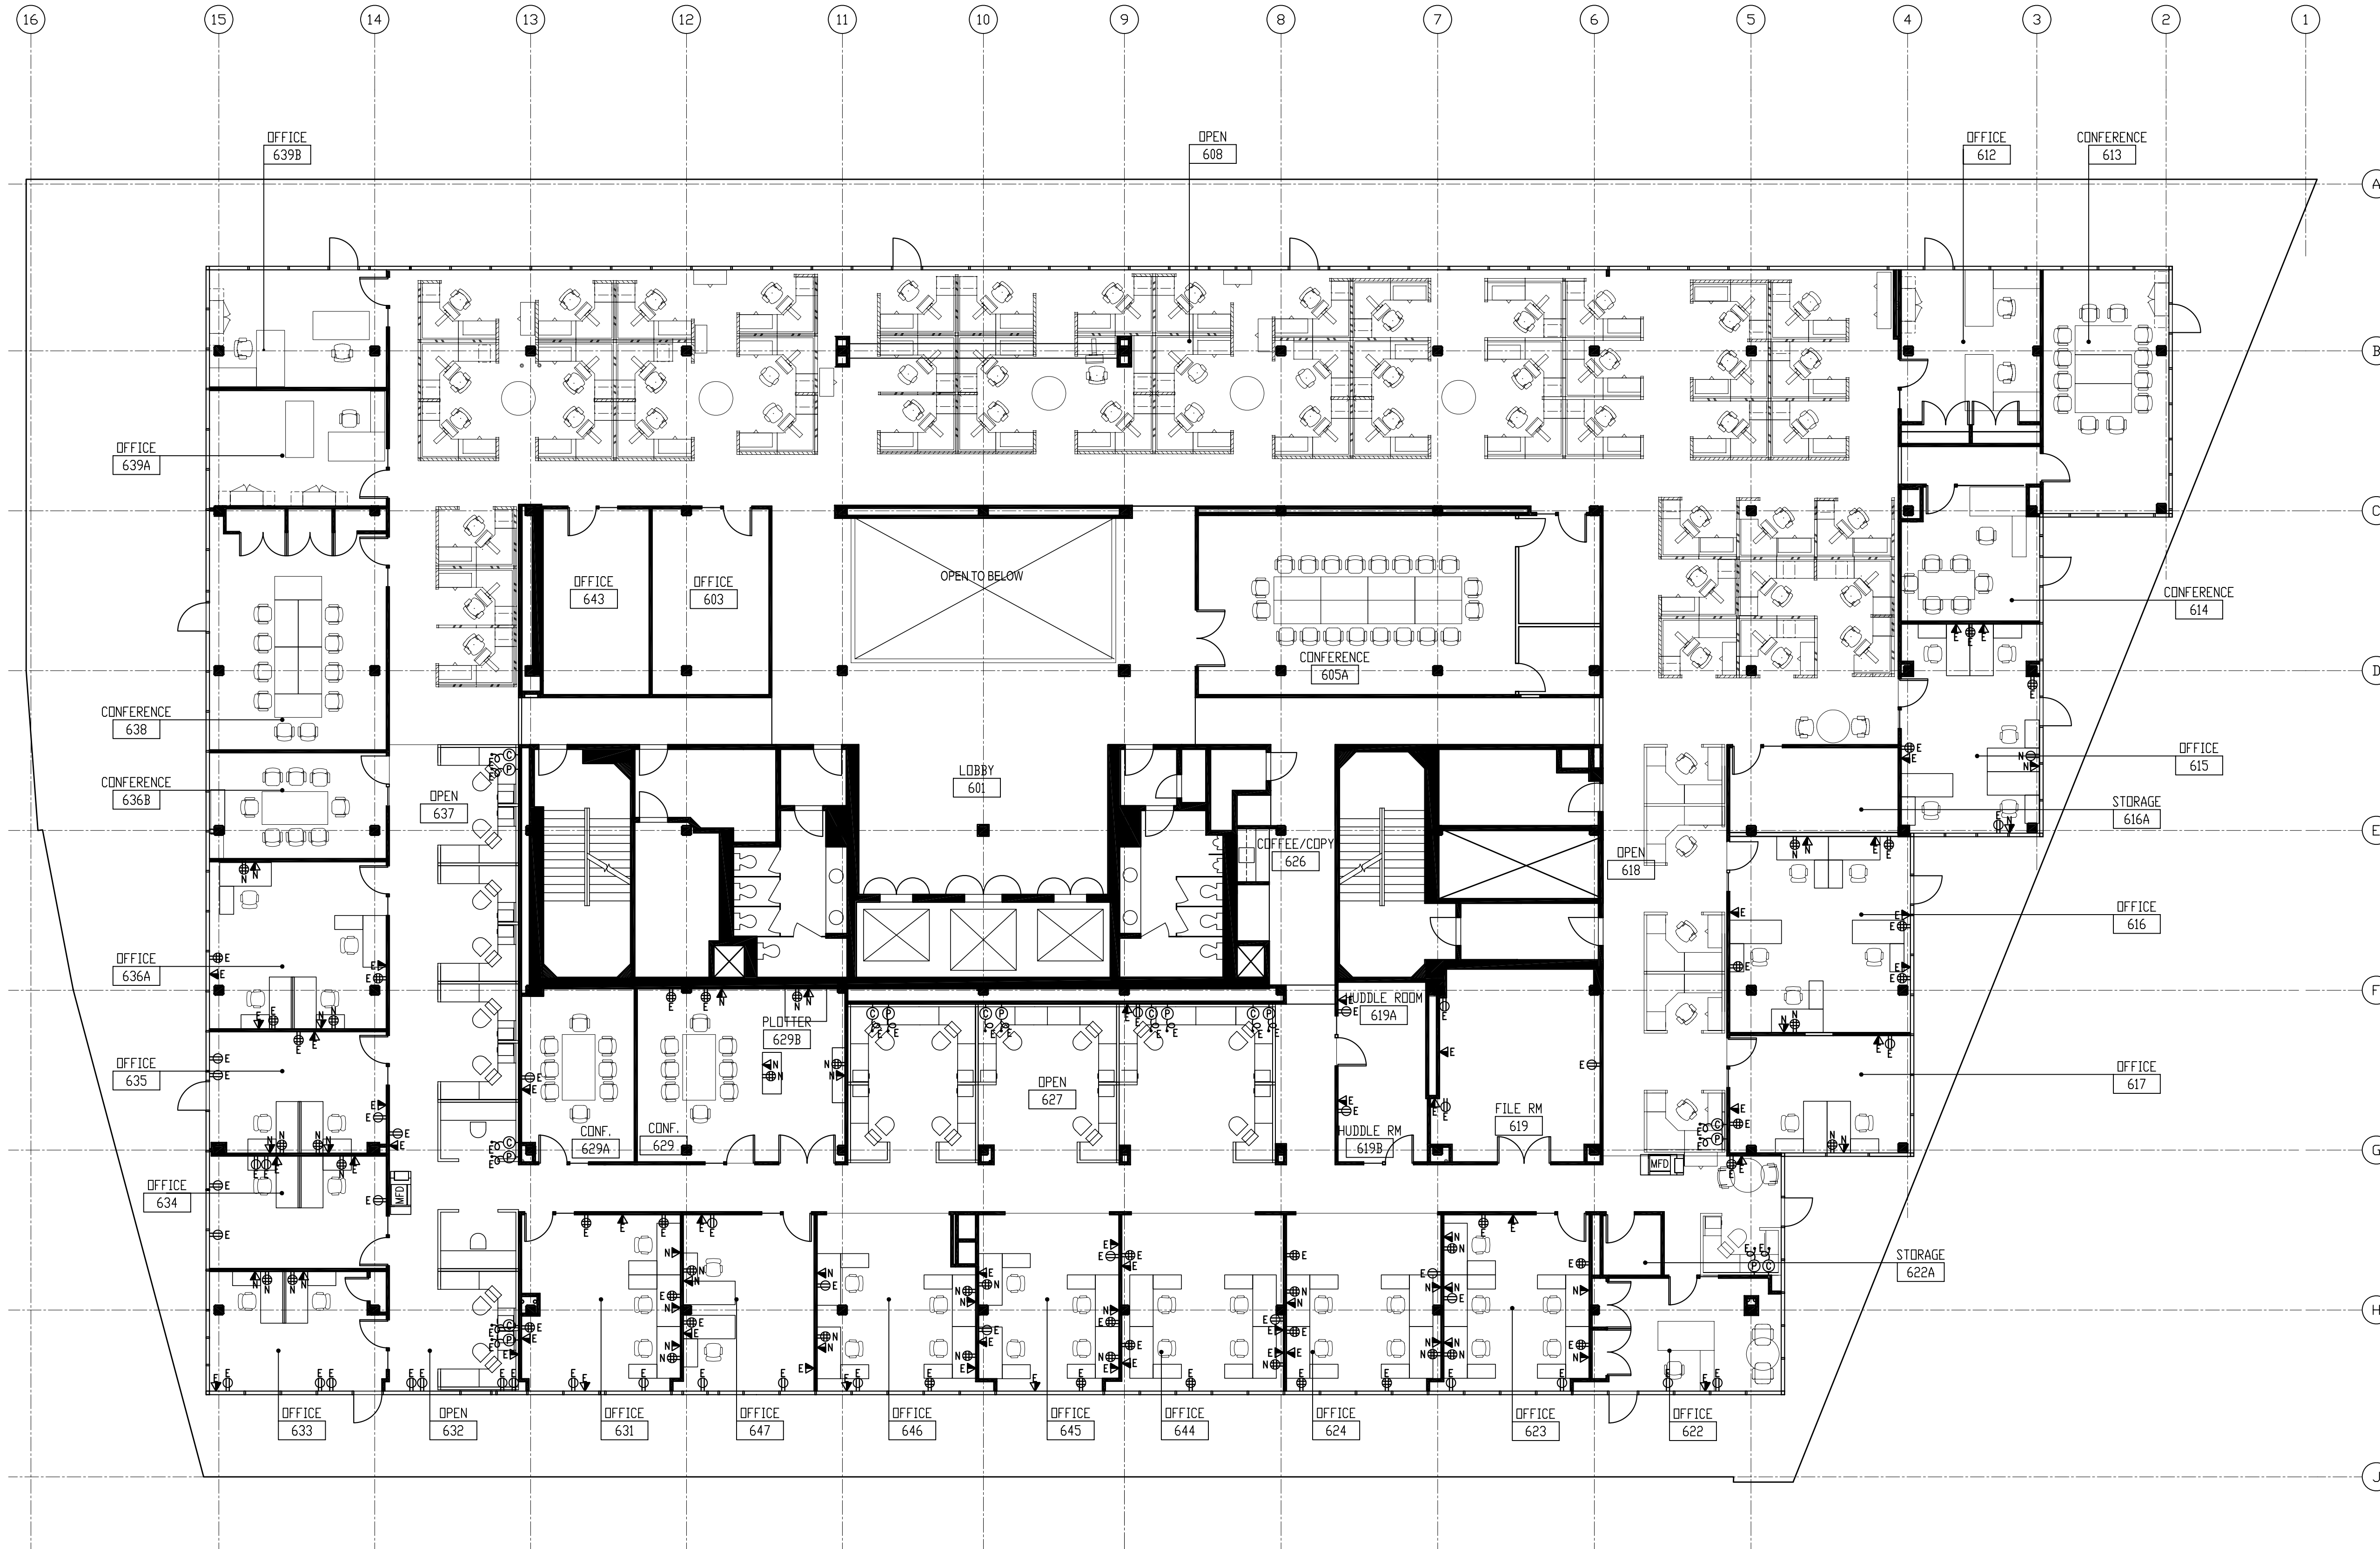

AS-BUILT EXAMPLES
NOT TO SCALE

NO. ISSUE/REVISION DATE

PROJECT _____


SCALE _____

DRAWN BY _____

DATE _____

DRAWING NO. _____

OFFICE SPACE

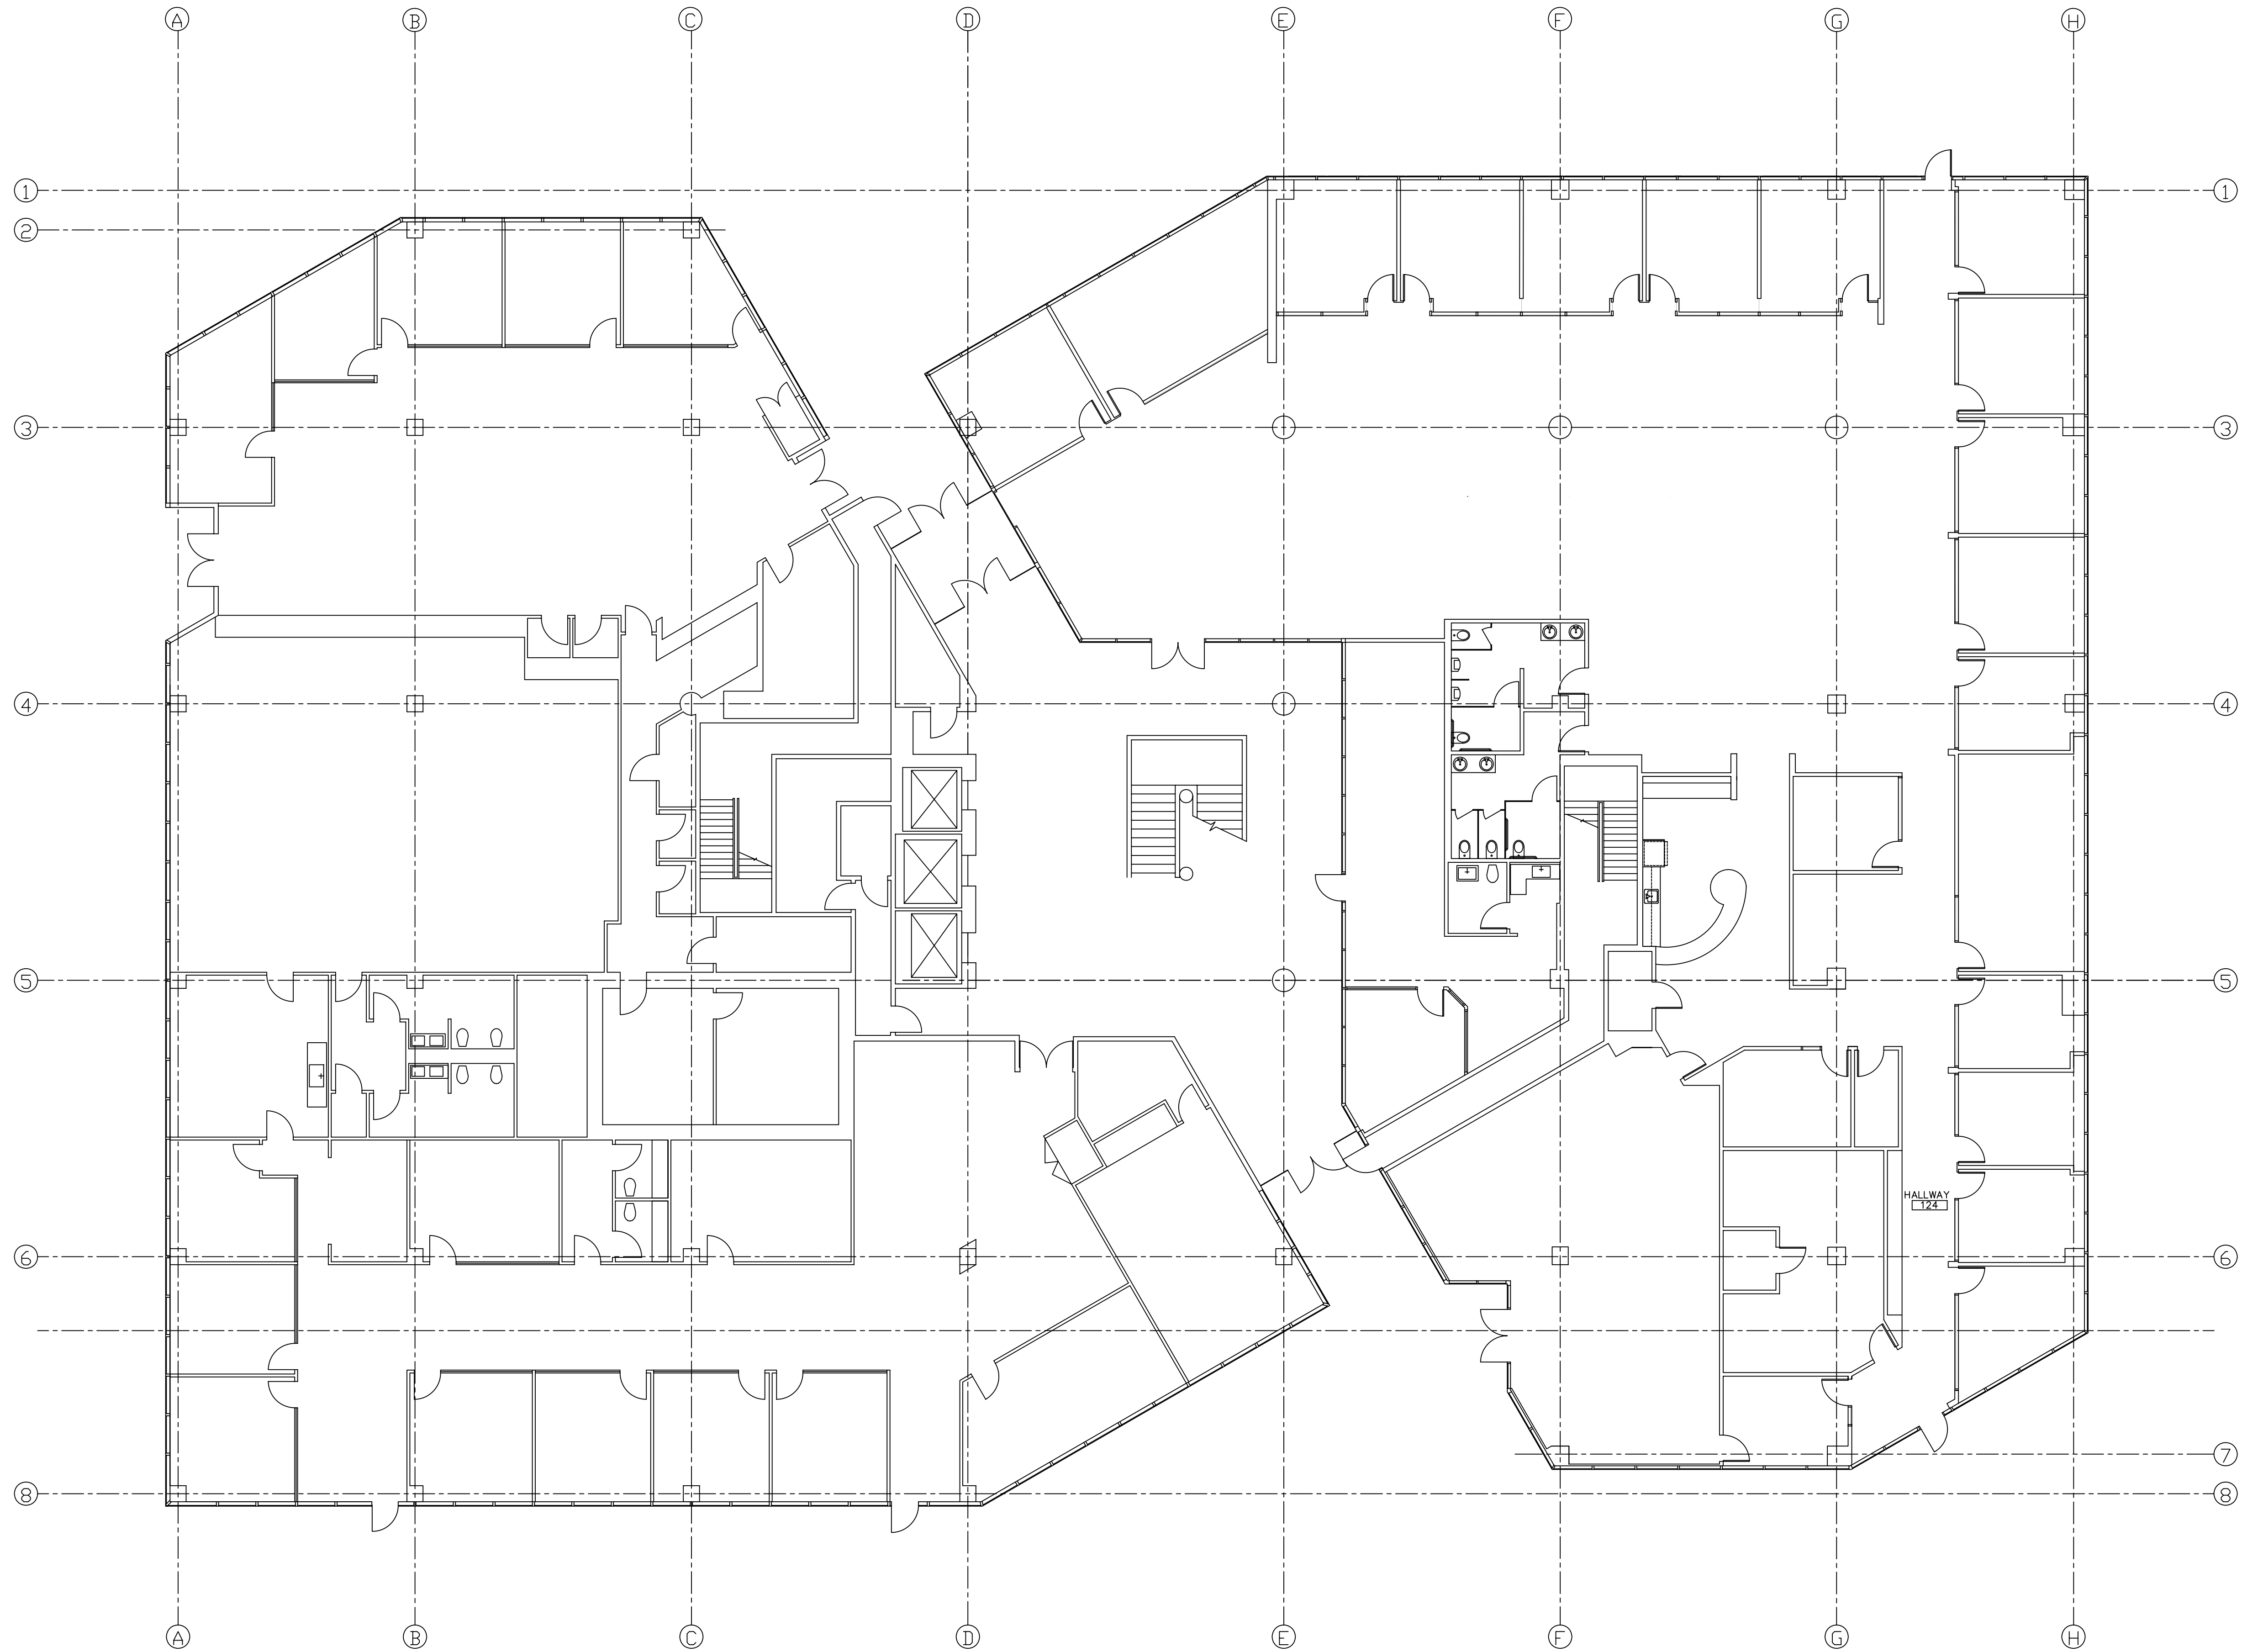

AS-BUILT EXAMPLES

NOT TO SCALE

NO. ISSUE/REVISION DATE


PROJECT _____

SCALE _____

DRAWN BY _____

DATE _____

DRAWING NO.
OFFICE SPACE

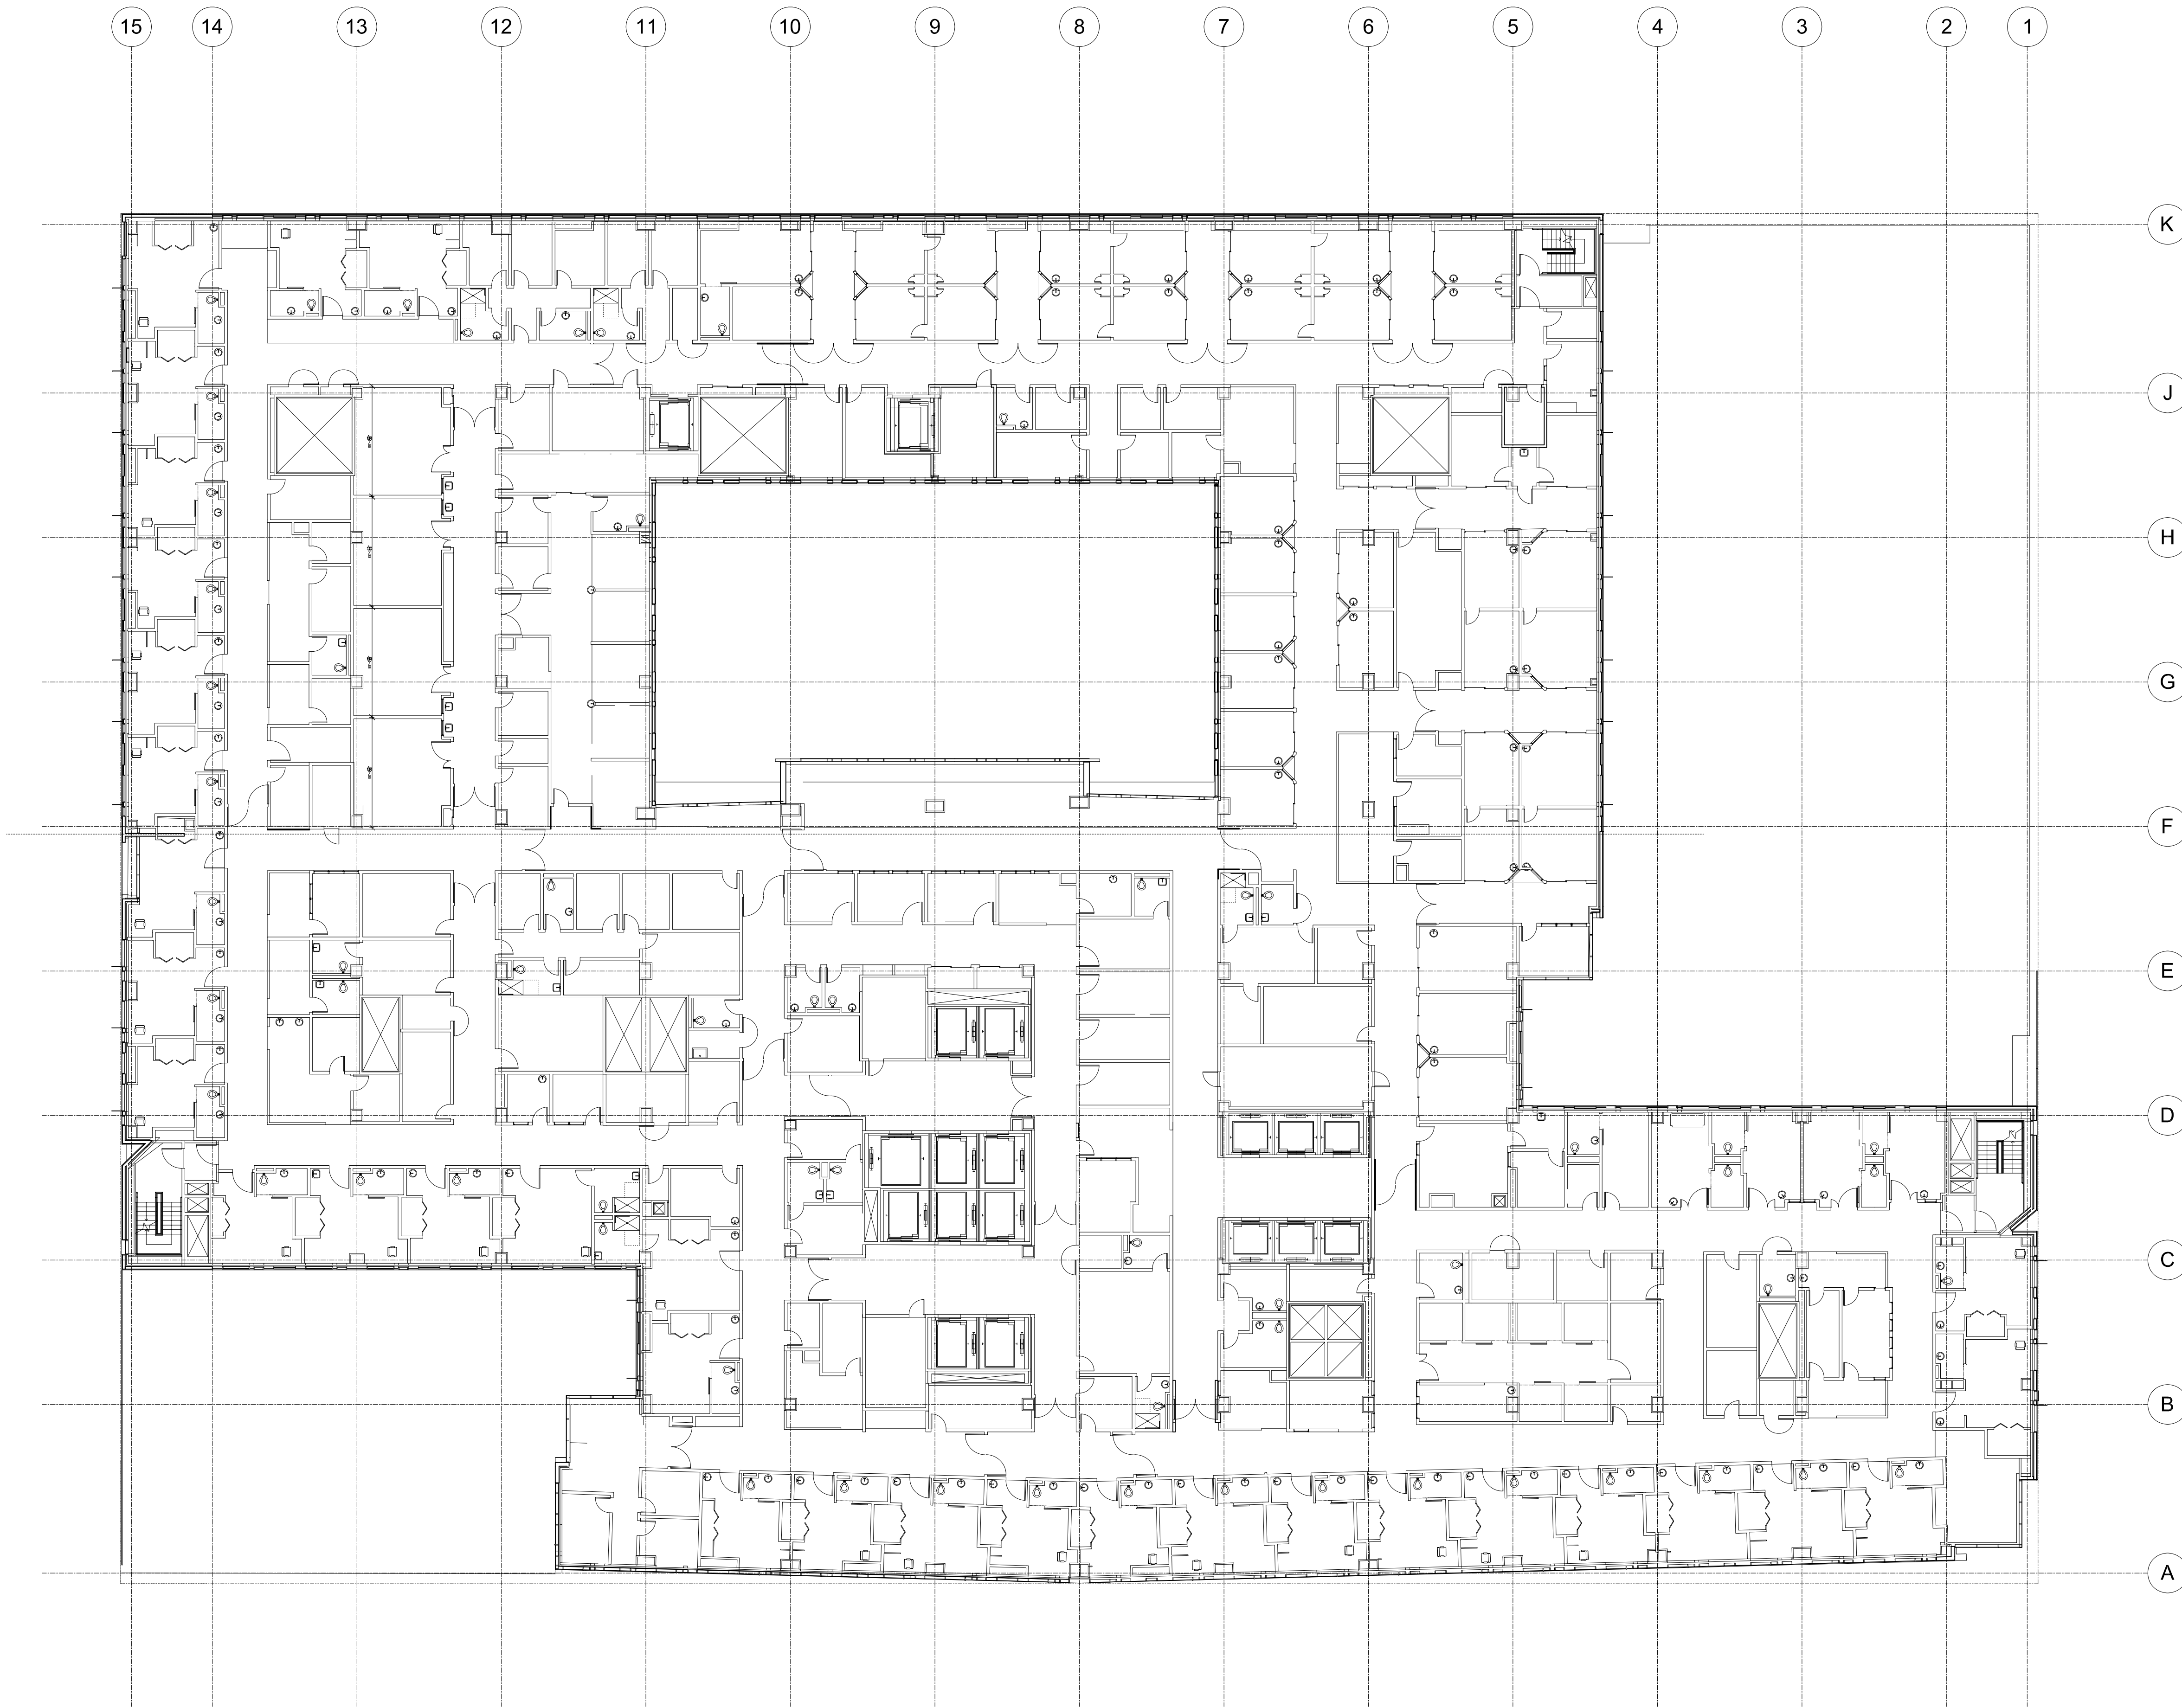

AS-BUILT EXAMPLES

NOT TO SCALE

NO. ISSUE/REVISION DATE

PROJECT _____

SCALE _____

DRAWN BY _____

DATE _____

DRAWING NO. _____
OFFICE SPACE



AS-BUILT EXAMPLES
NOT TO SCALE

NO. ISSUE/REVISION DATE


PROJECT _____

SCALE _____

DRAWN BY _____

DATE _____

DRAWING NO.
OFFICE SPACE

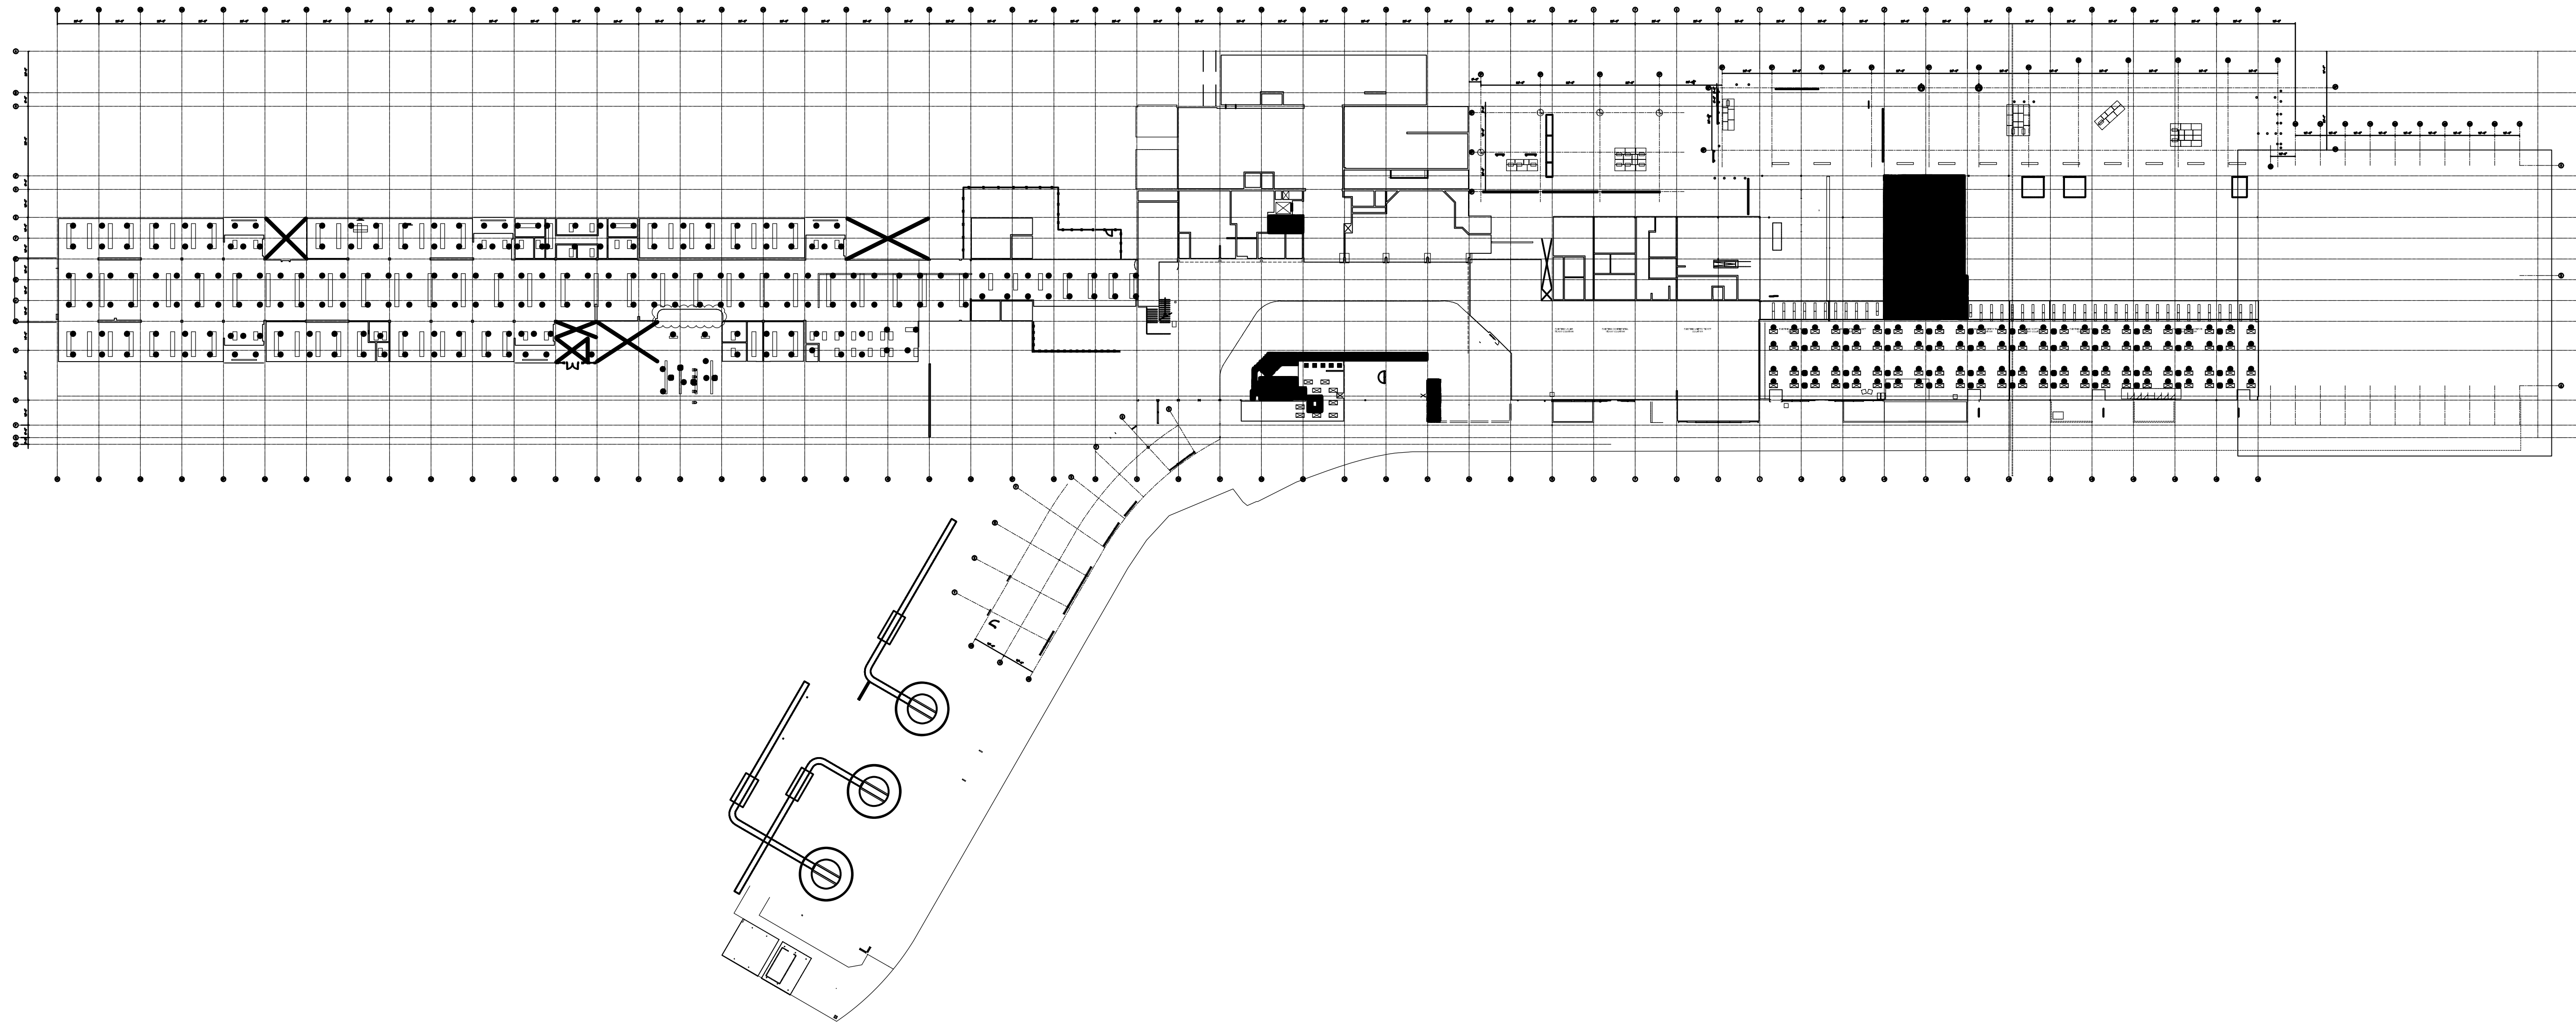

AS-BUILT EXAMPLES

NOT TO SCALE

NO.	ISSUE/REVISION	DATE
-----	----------------	------

PROJECT _____


SCALE _____

DRAWN BY _____

DATE _____

DRAWING NO.
OFFICE SPACE

A1.7

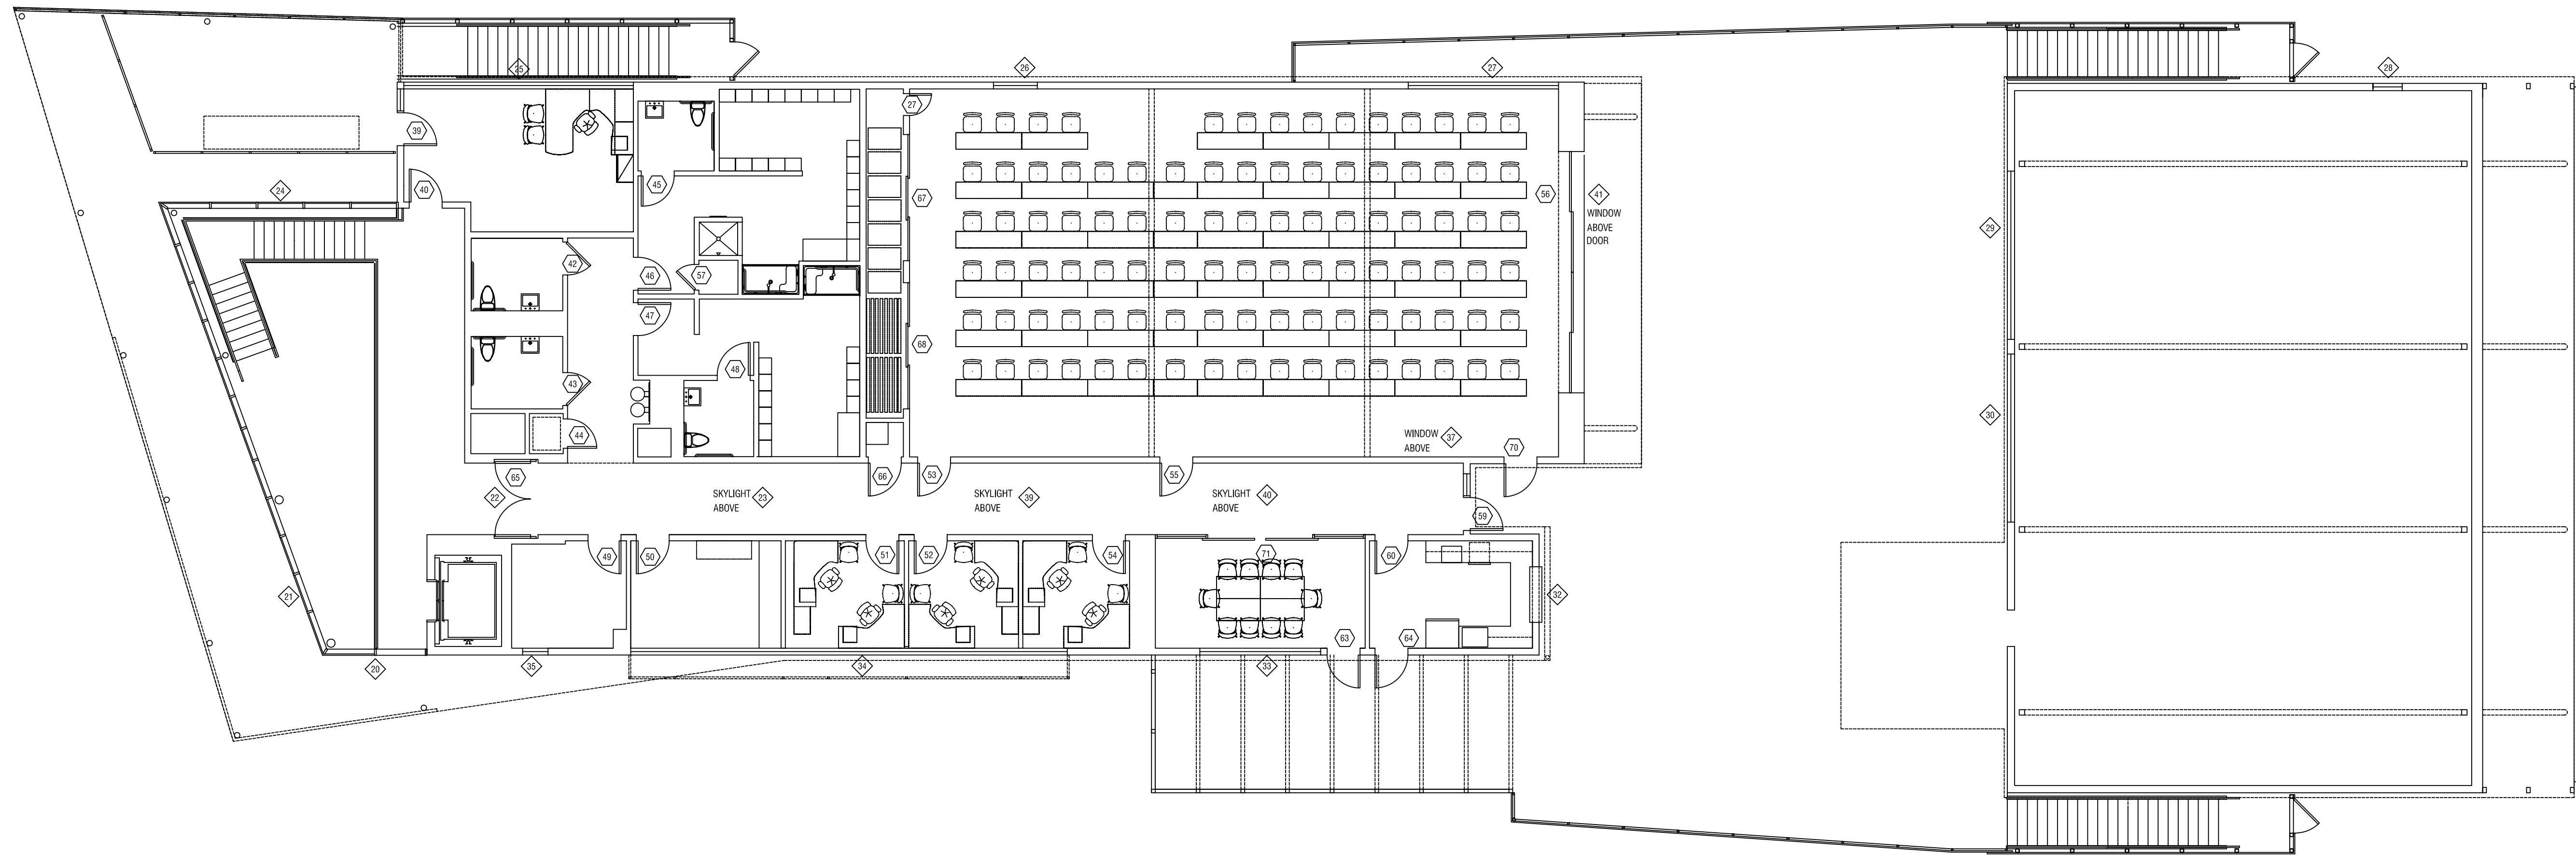

AS-BUILT EXAMPLES

NOT TO SCALE

NO. ISSUE/REVISION DATE

PROJECT _____



SCALE _____

DRAWN BY _____

DATE _____

DRAWING NO. _____
SPECIALTY PROJECTS

A2.0

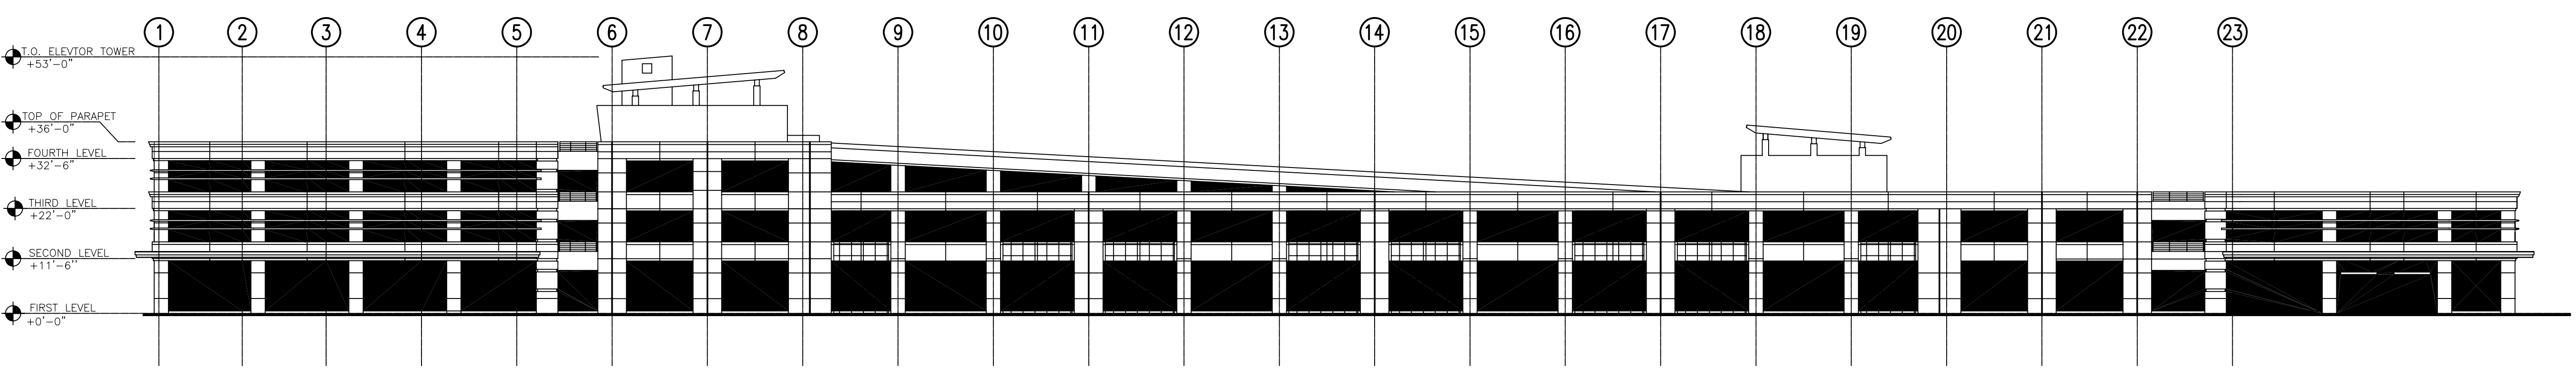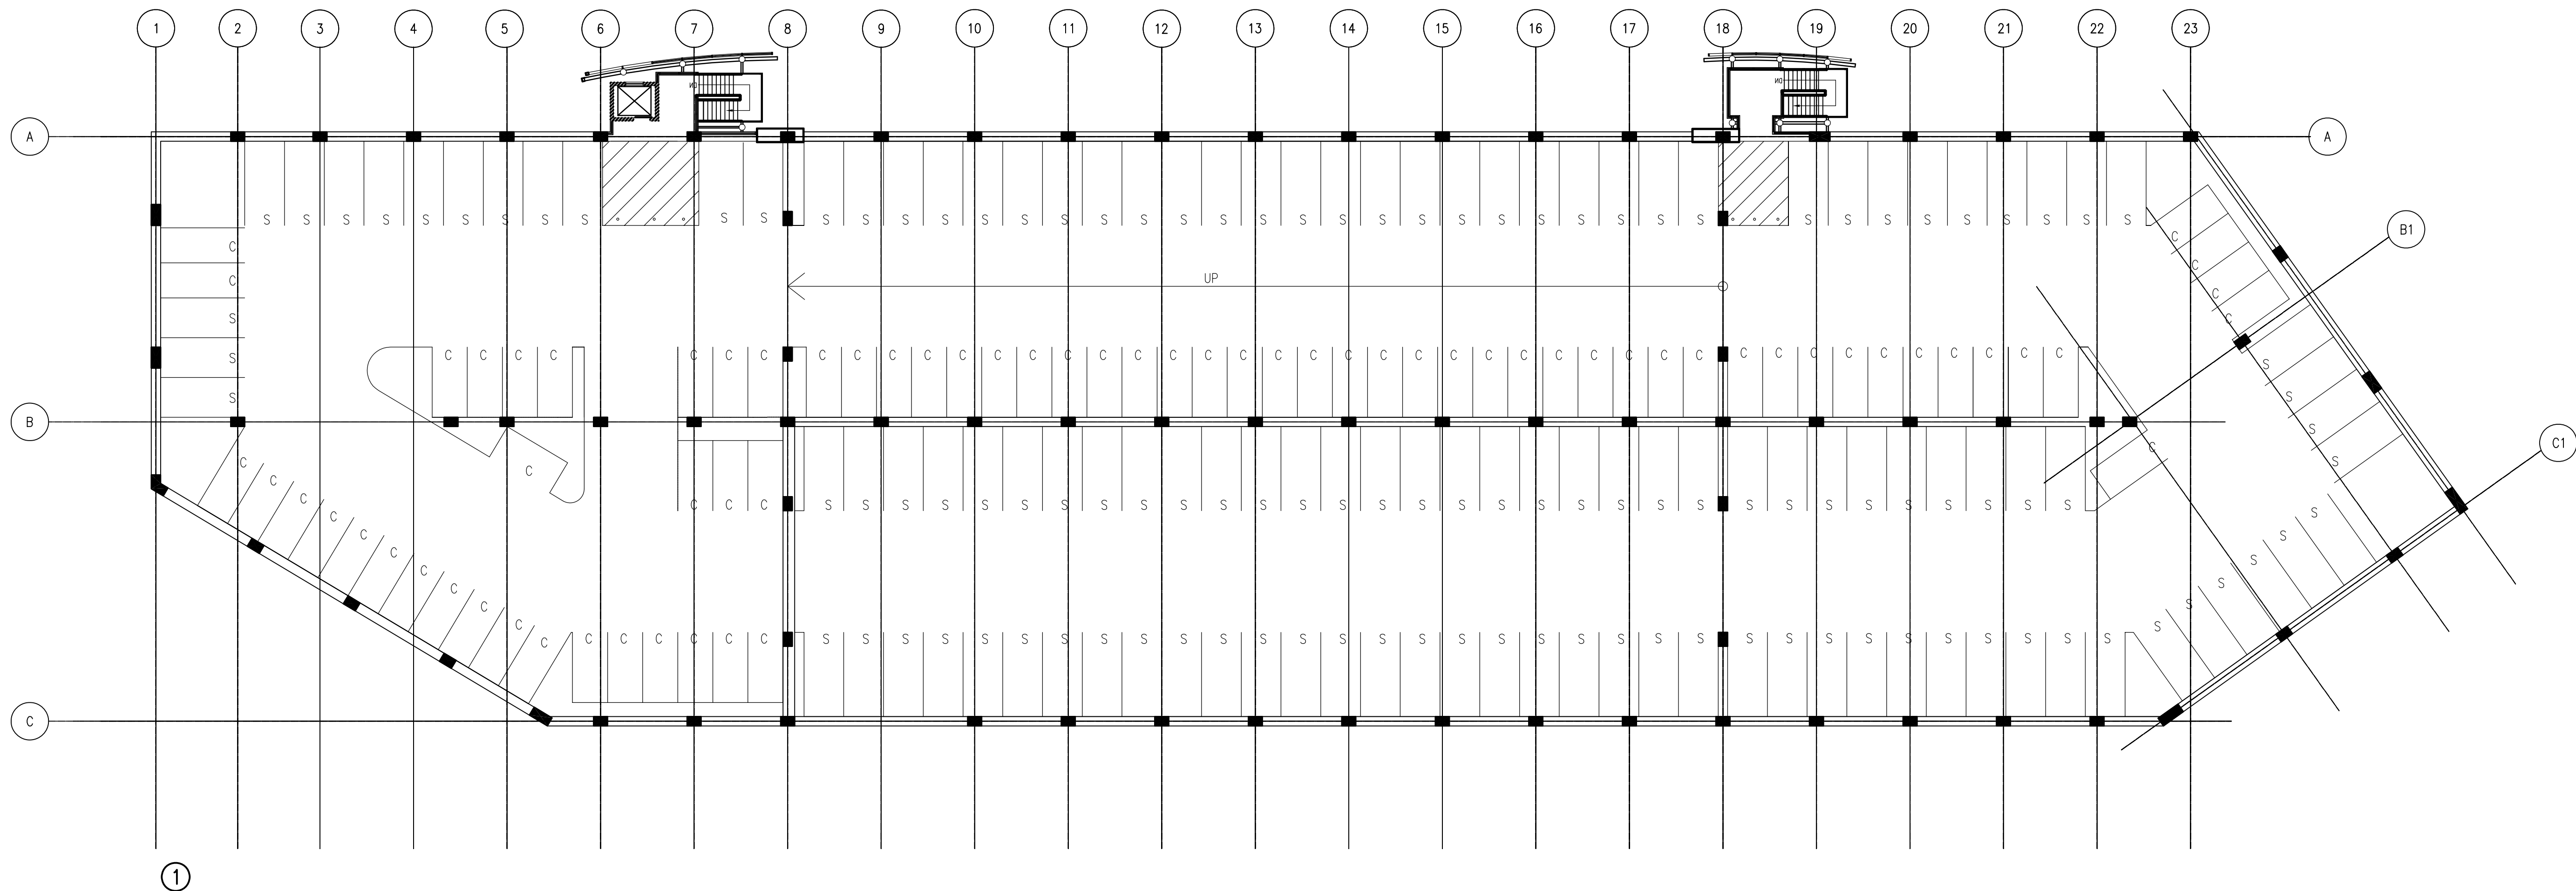


AS-BUILT EXAMPLES
NOT TO SCALE

NO. ISSUE/REVISION DATE

PROJECT _____
SCALE _____
DRAWN BY _____
DATE _____

DRAWING NO. SPECIALTY PROJECTS

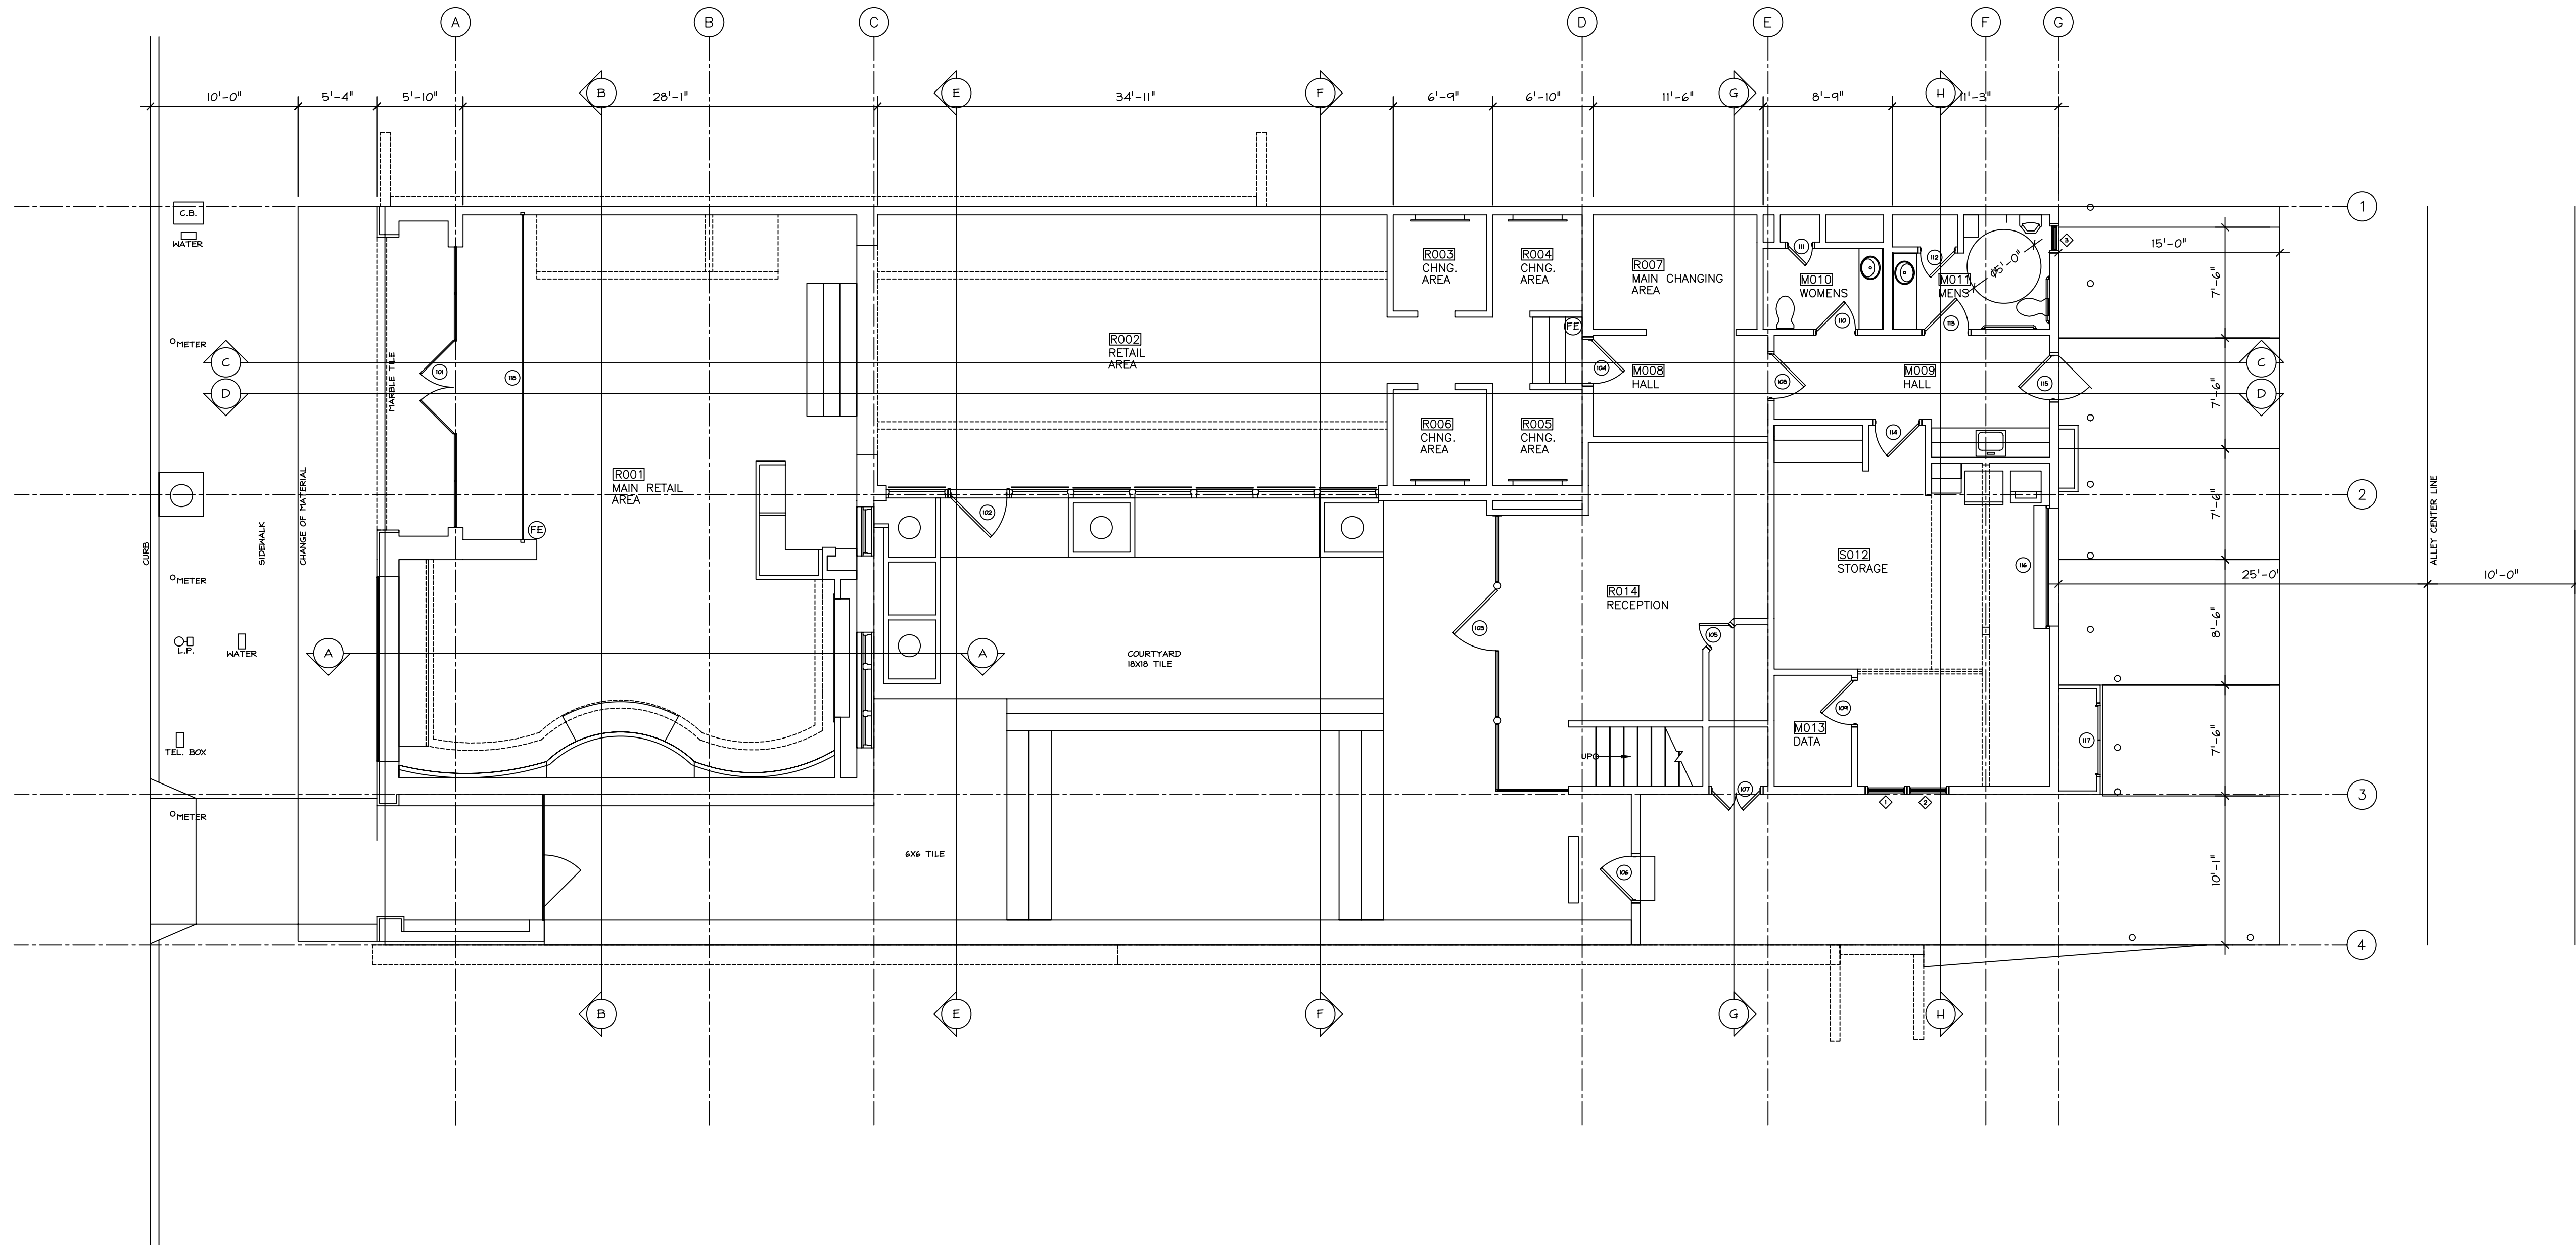

AS-BUILT EXAMPLES
NOT TO SCALE

NO.	ISSUE/REVISION	DATE


PROJECT _____

SCALE _____

DRAWN BY _____

DATE _____

DRAWING NO.
SPECIALTY PROJECTS

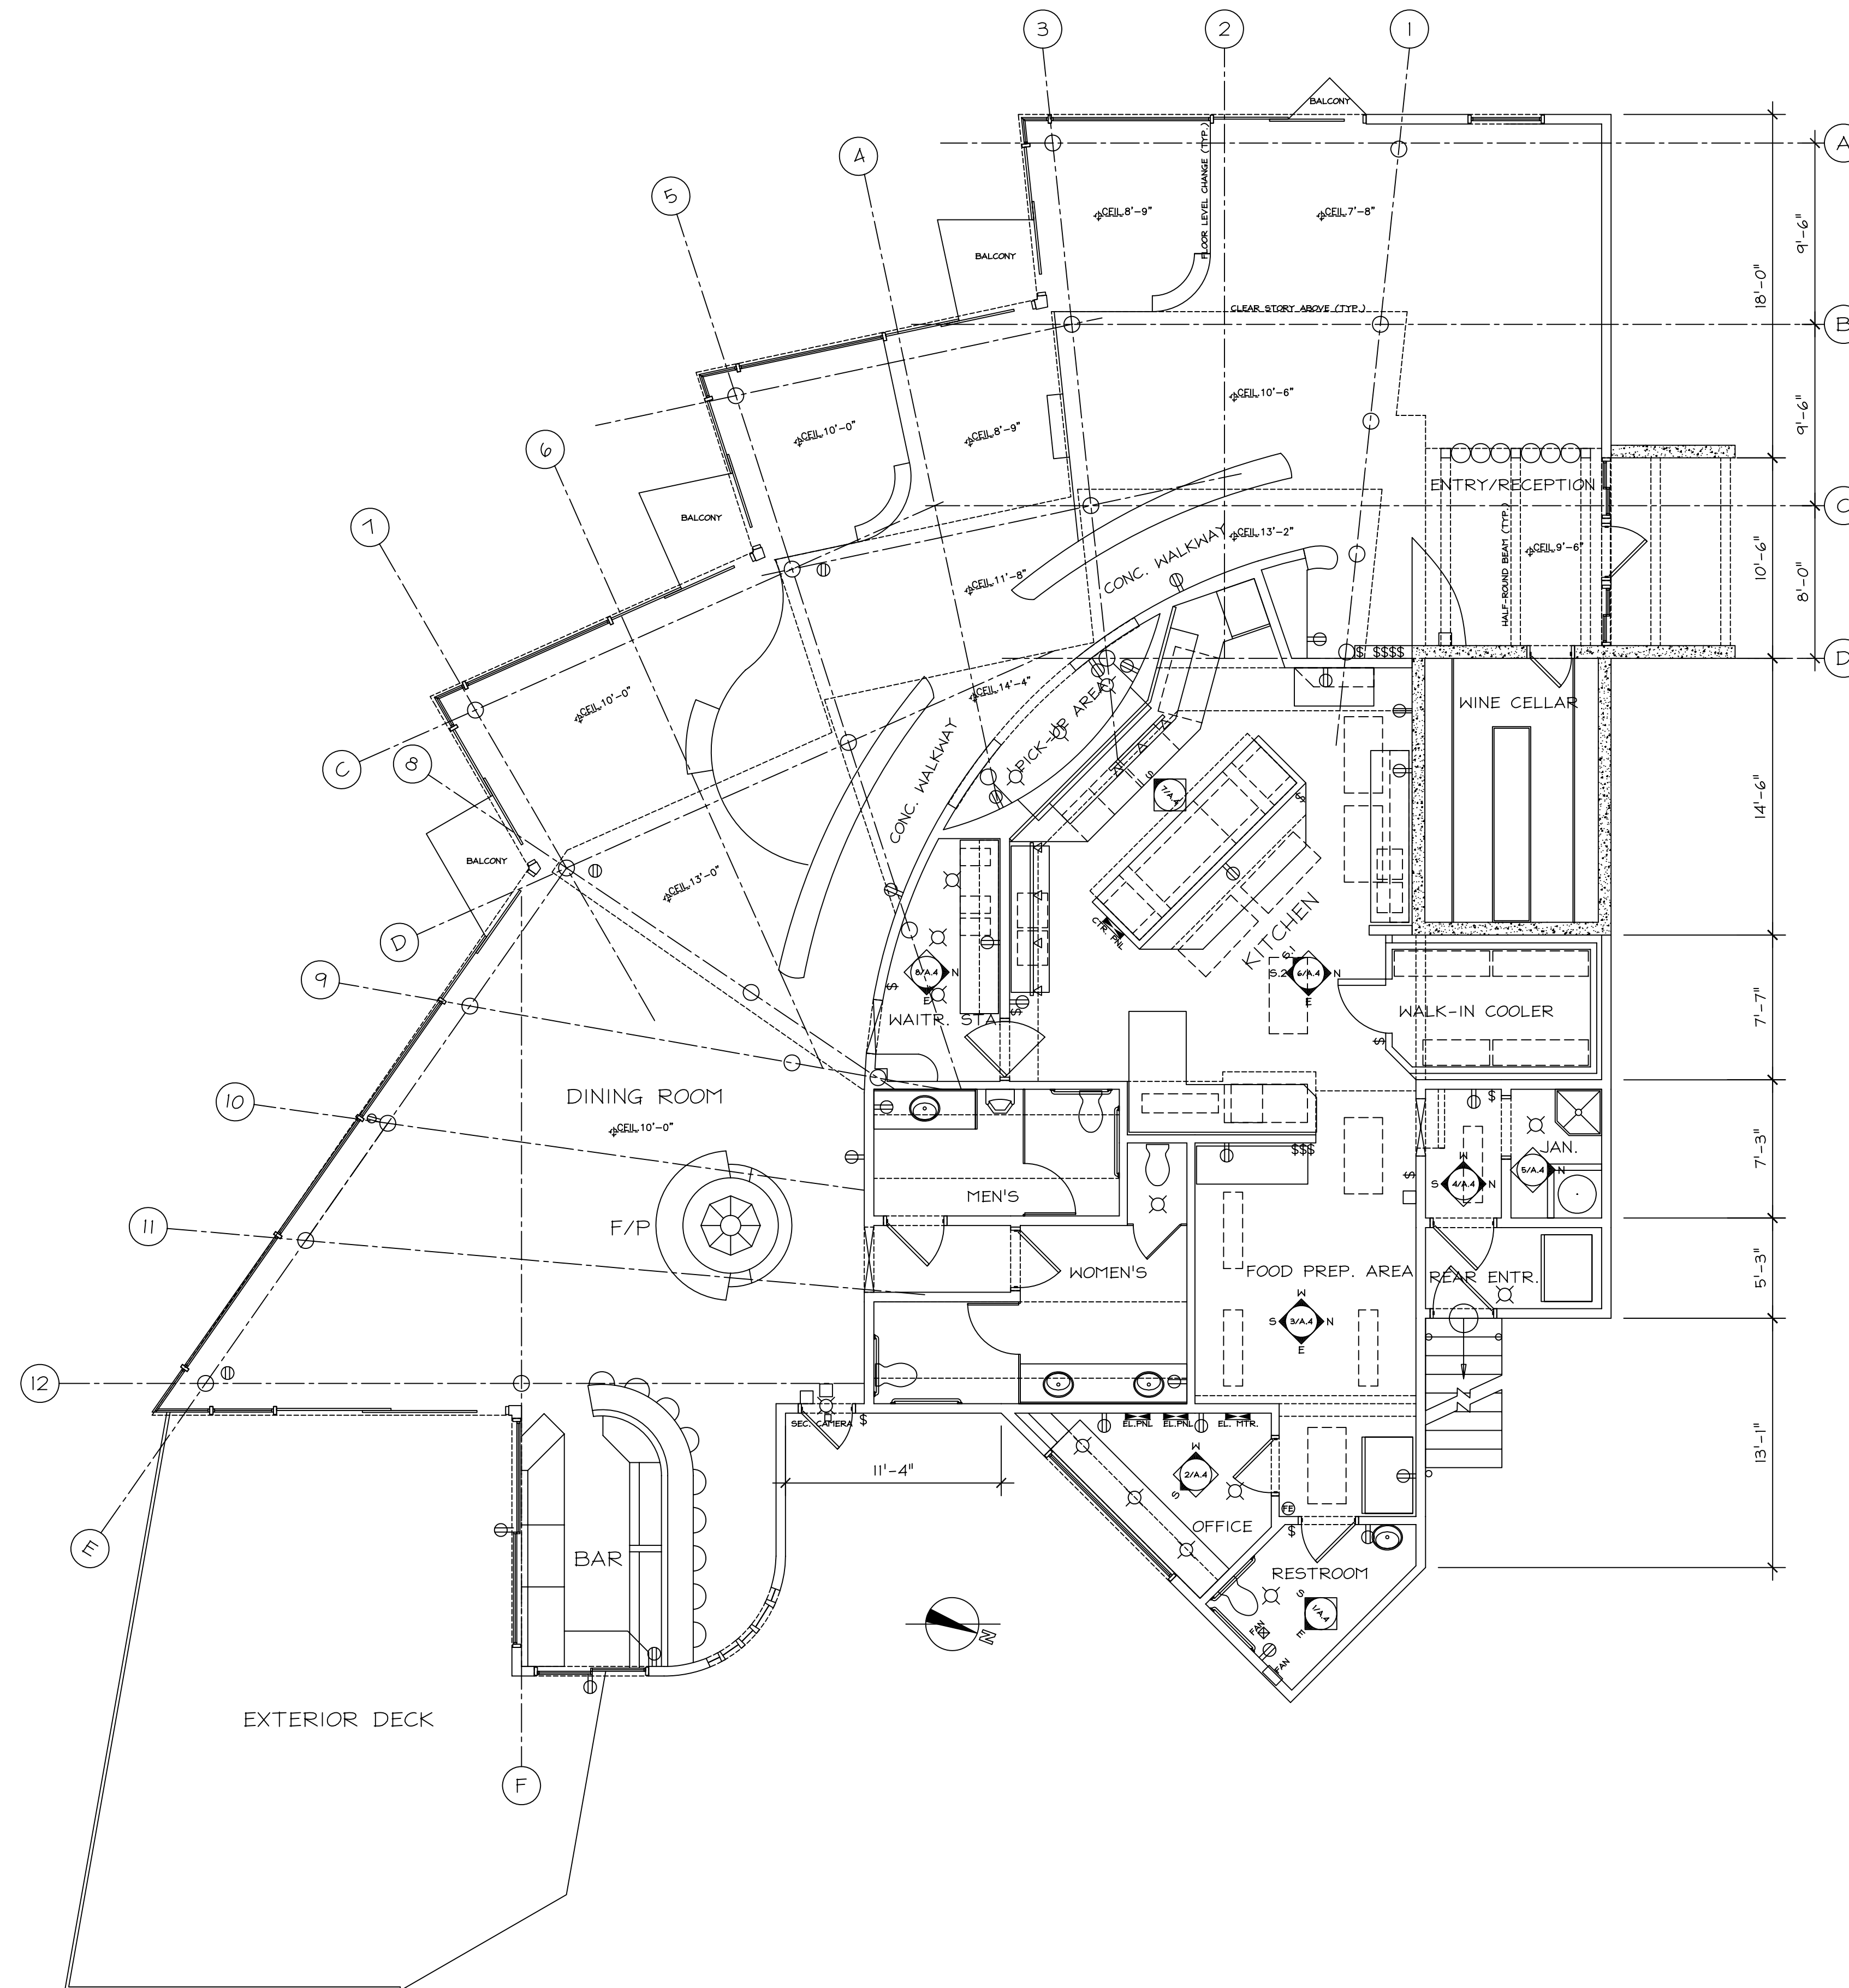

AS-BUILT EXAMPLES

NOT TO SCALE

NO.	ISSUE/REVISION	DATE


PROJECT _____

SCALE _____

DRAWN BY _____

DATE _____

DRAWING NO. SPECIALTY PROJECTS

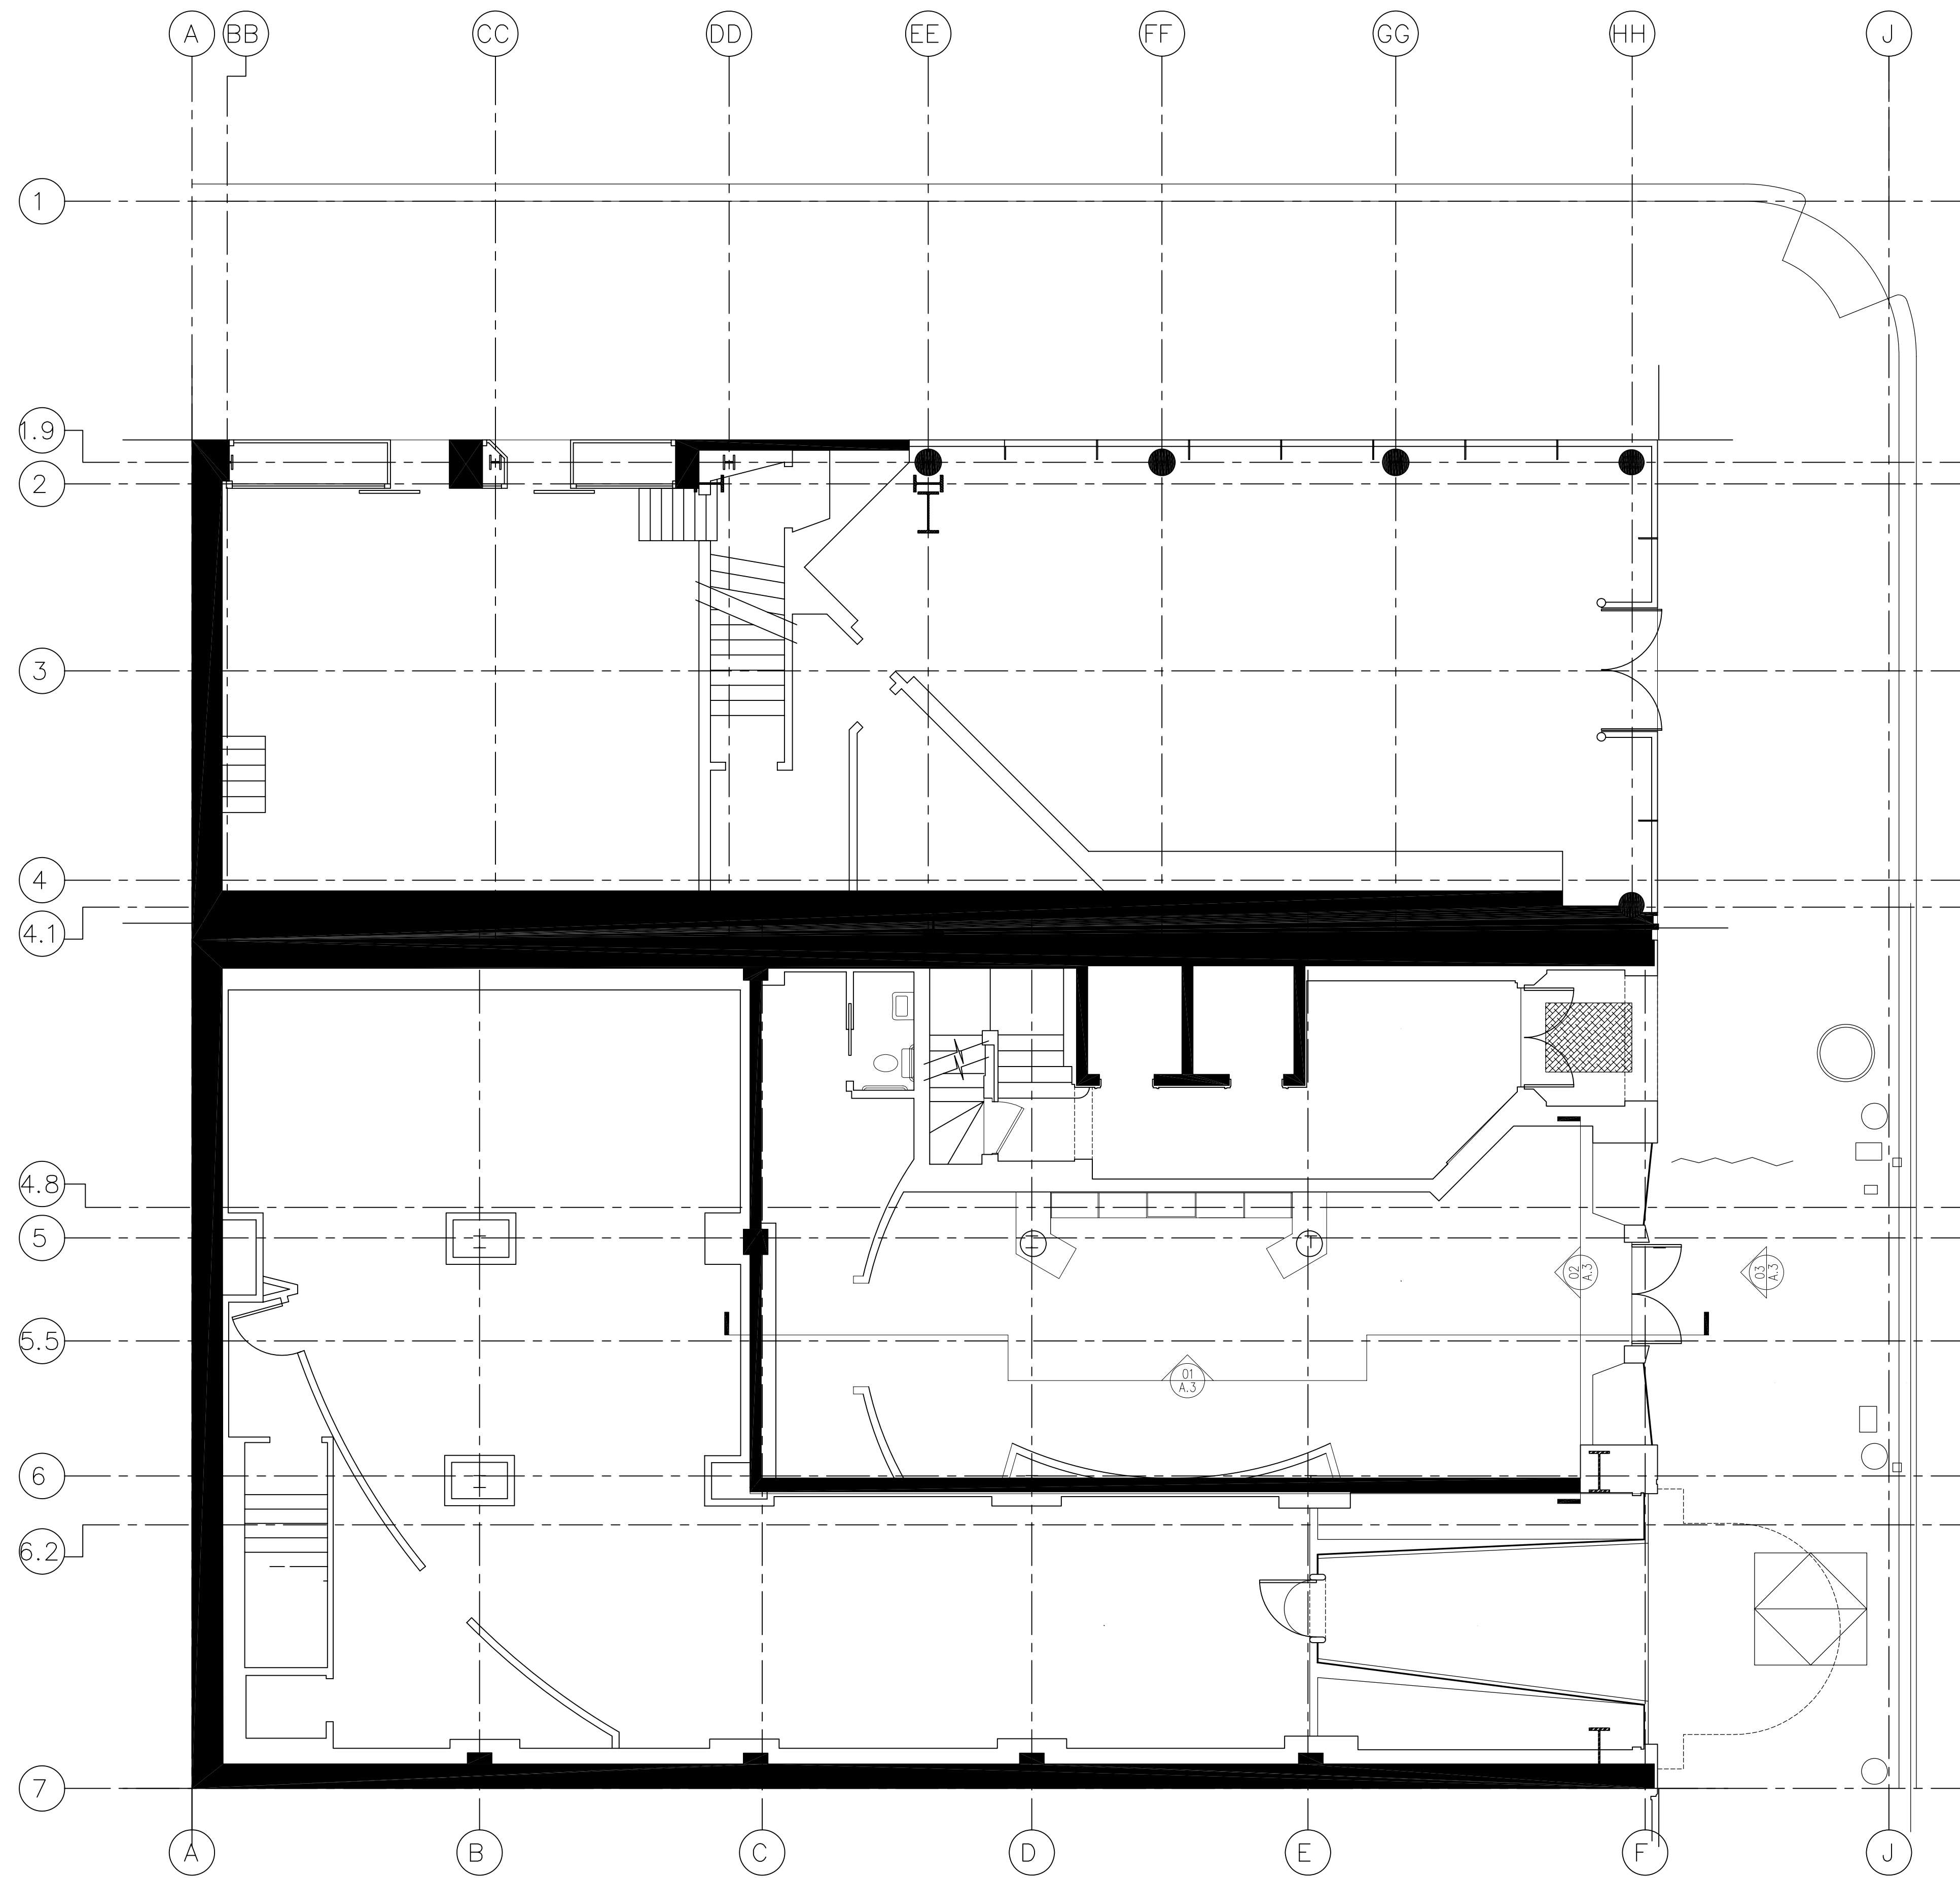

AS-BUILT EXAMPLES

NOT TO SCALE

NO. ISSUE/REVISION DATE

PROJECT _____


SCALE _____

DRAWN BY _____

DATE _____

DRAWING NO. _____
SPECIALTY PROJECTS

A2.4

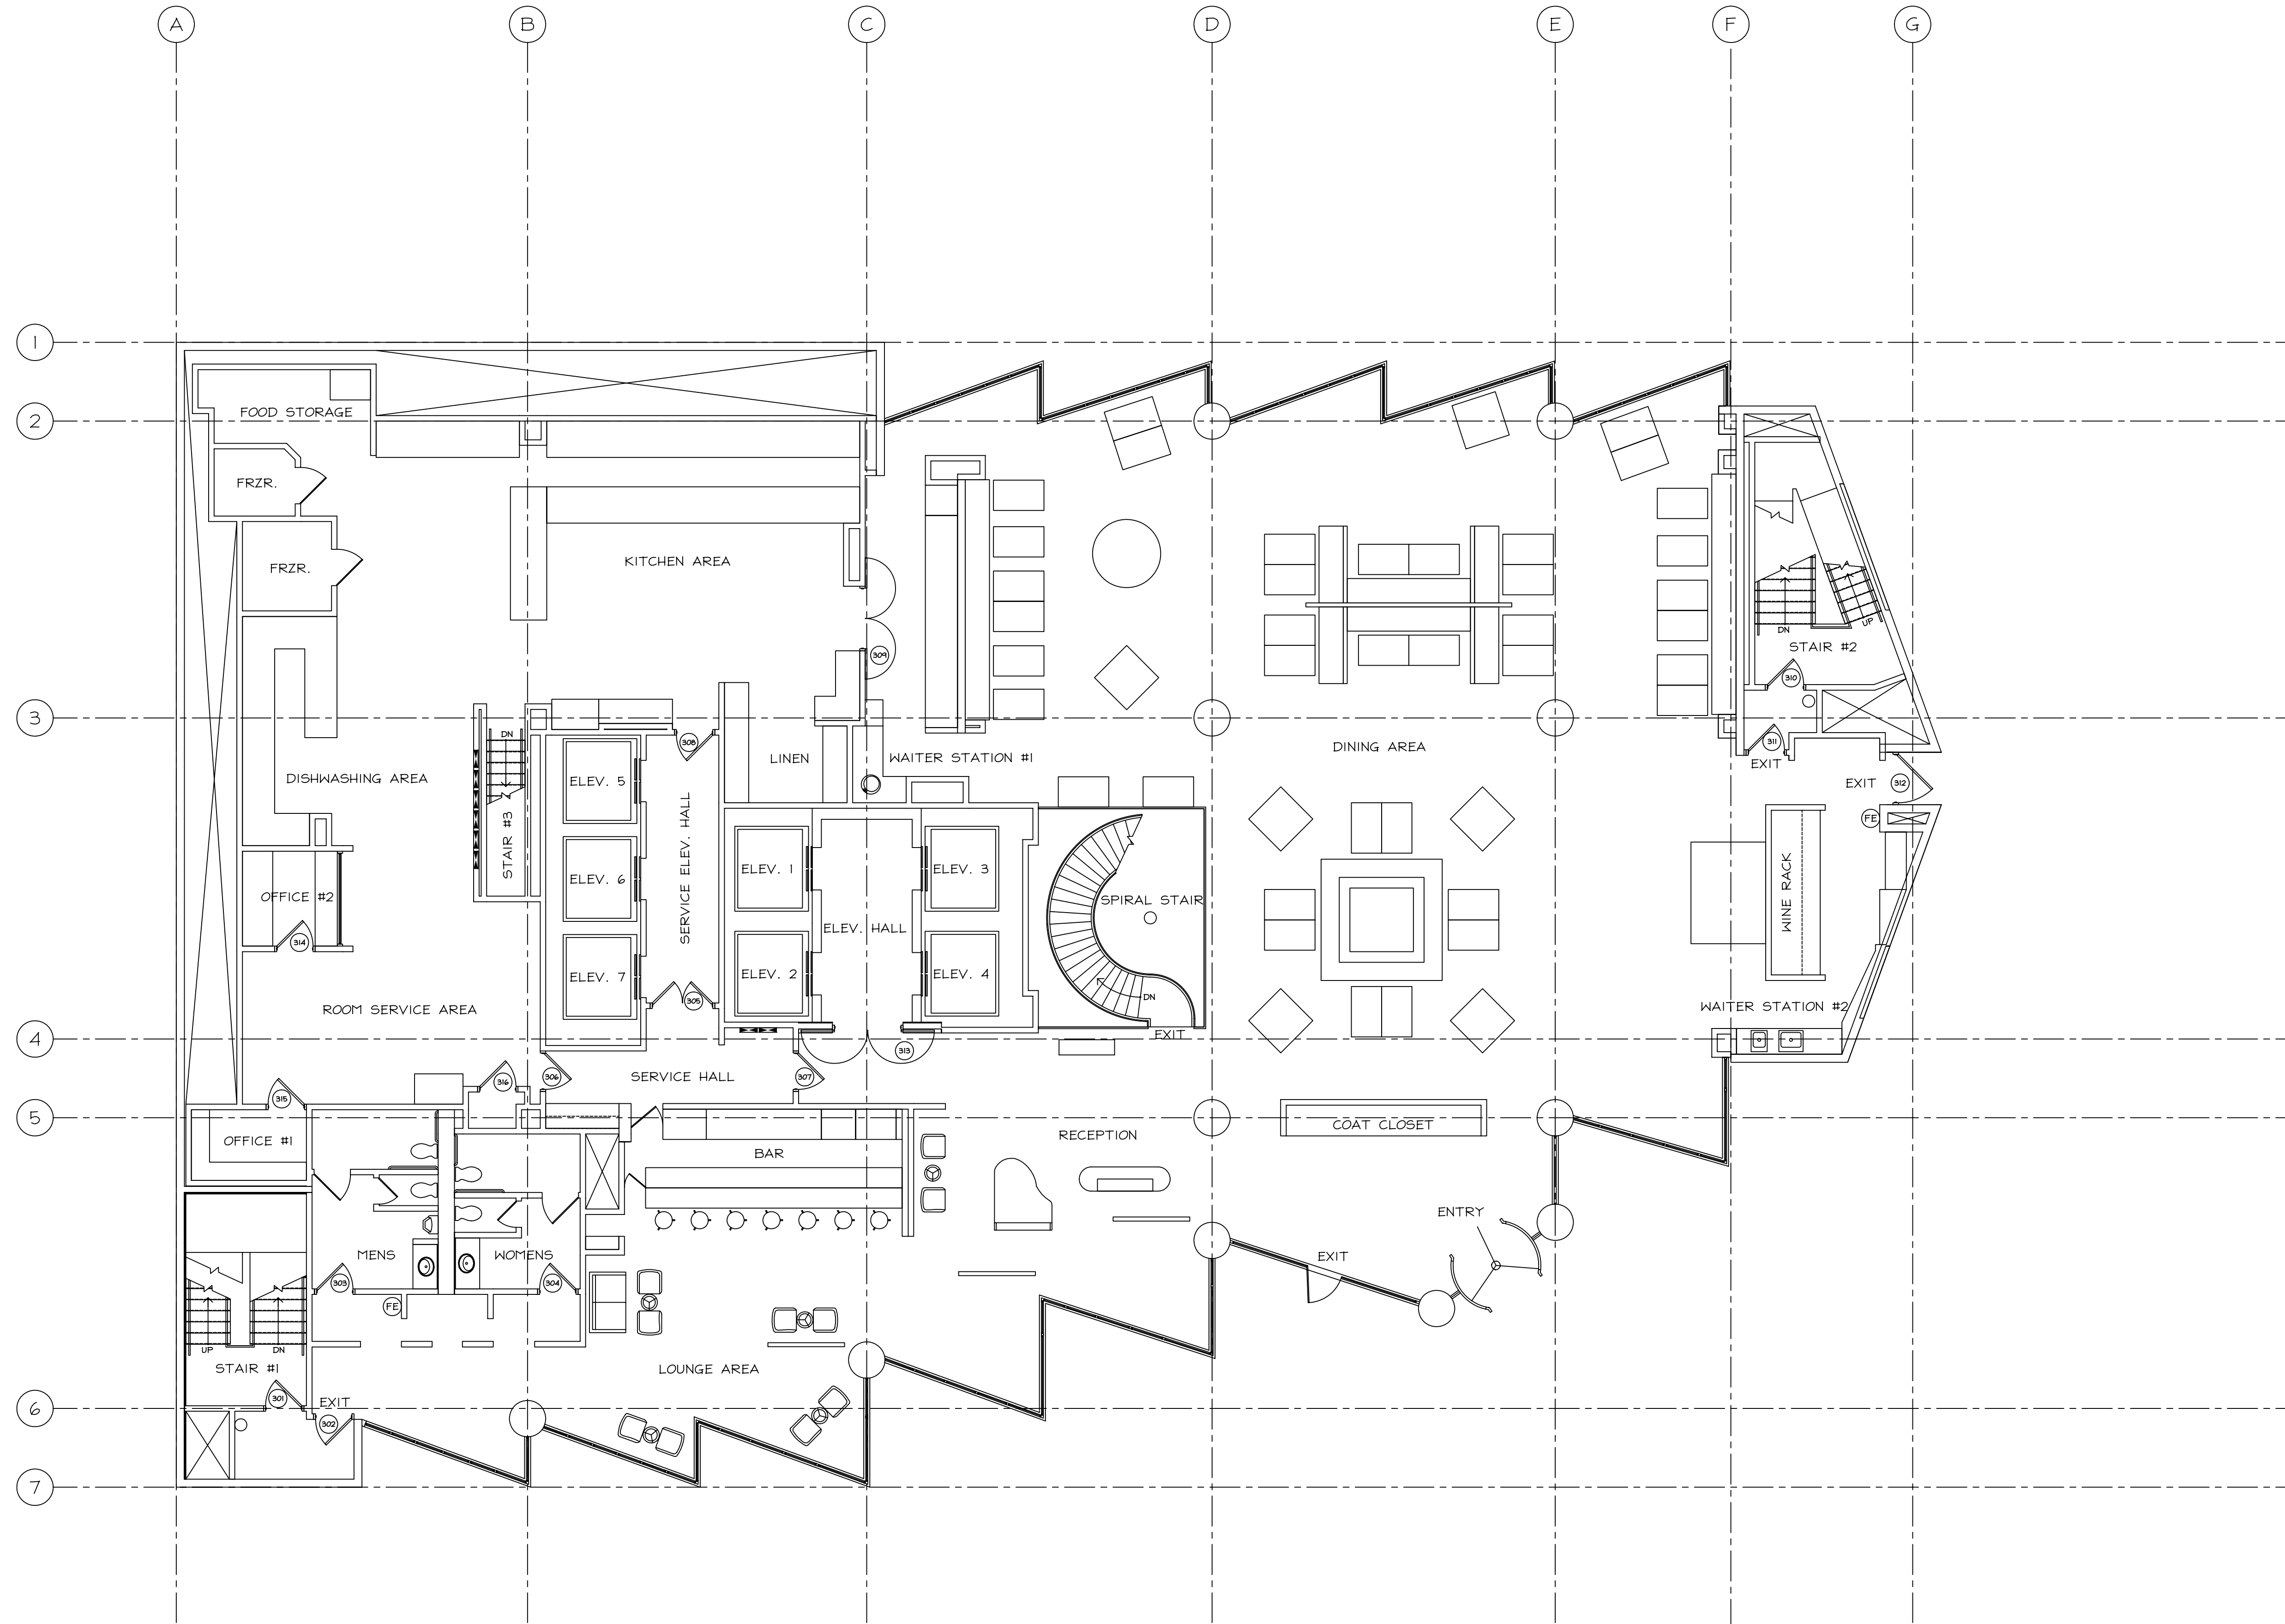

AS-BUILT EXAMPLES

NOT TO SCALE

NO.	ISSUE/REVISION	DATE


PROJECT _____

SCALE _____

DRAWN BY _____

DATE _____

DRAWING NO. _____
SPECIALTY PROJECTS

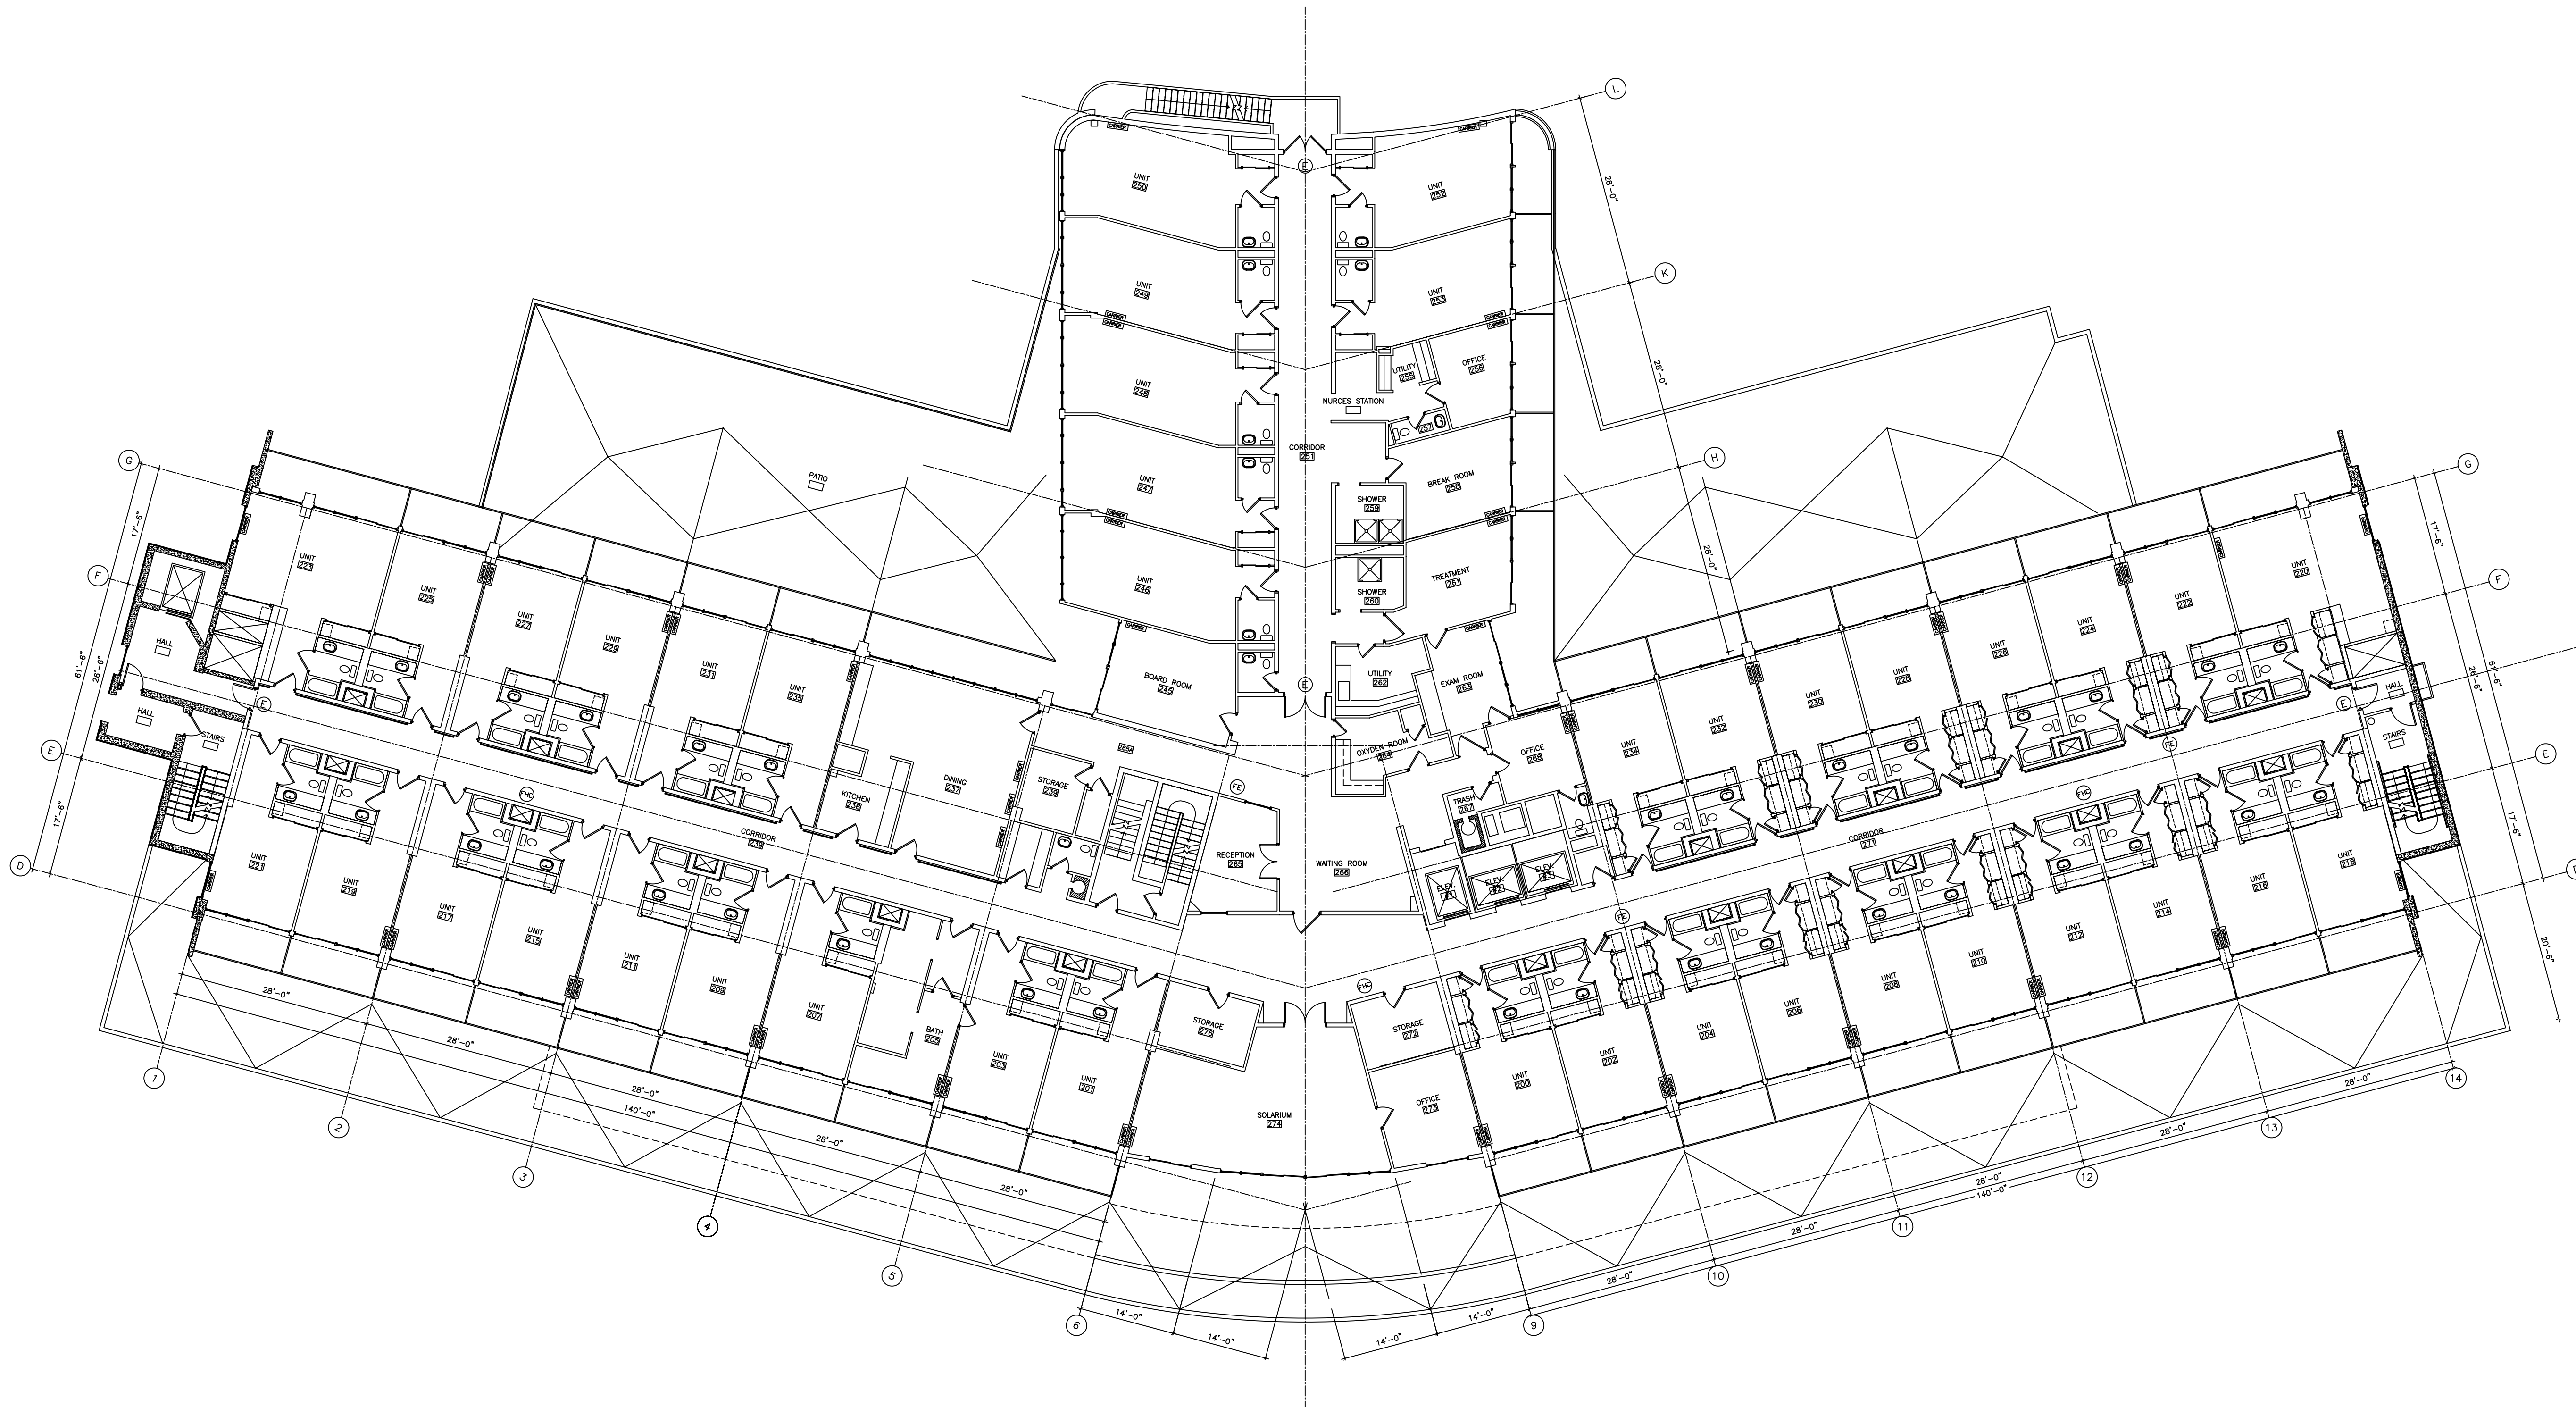

AS-BUILT EXAMPLES

NOT TO SCALE

NO.	ISSUE/REVISION	DATE


PROJECT _____

SCALE _____

DRAWN BY _____

DATE _____

DRAWING NO. _____
SPECIALTY PROJECTS

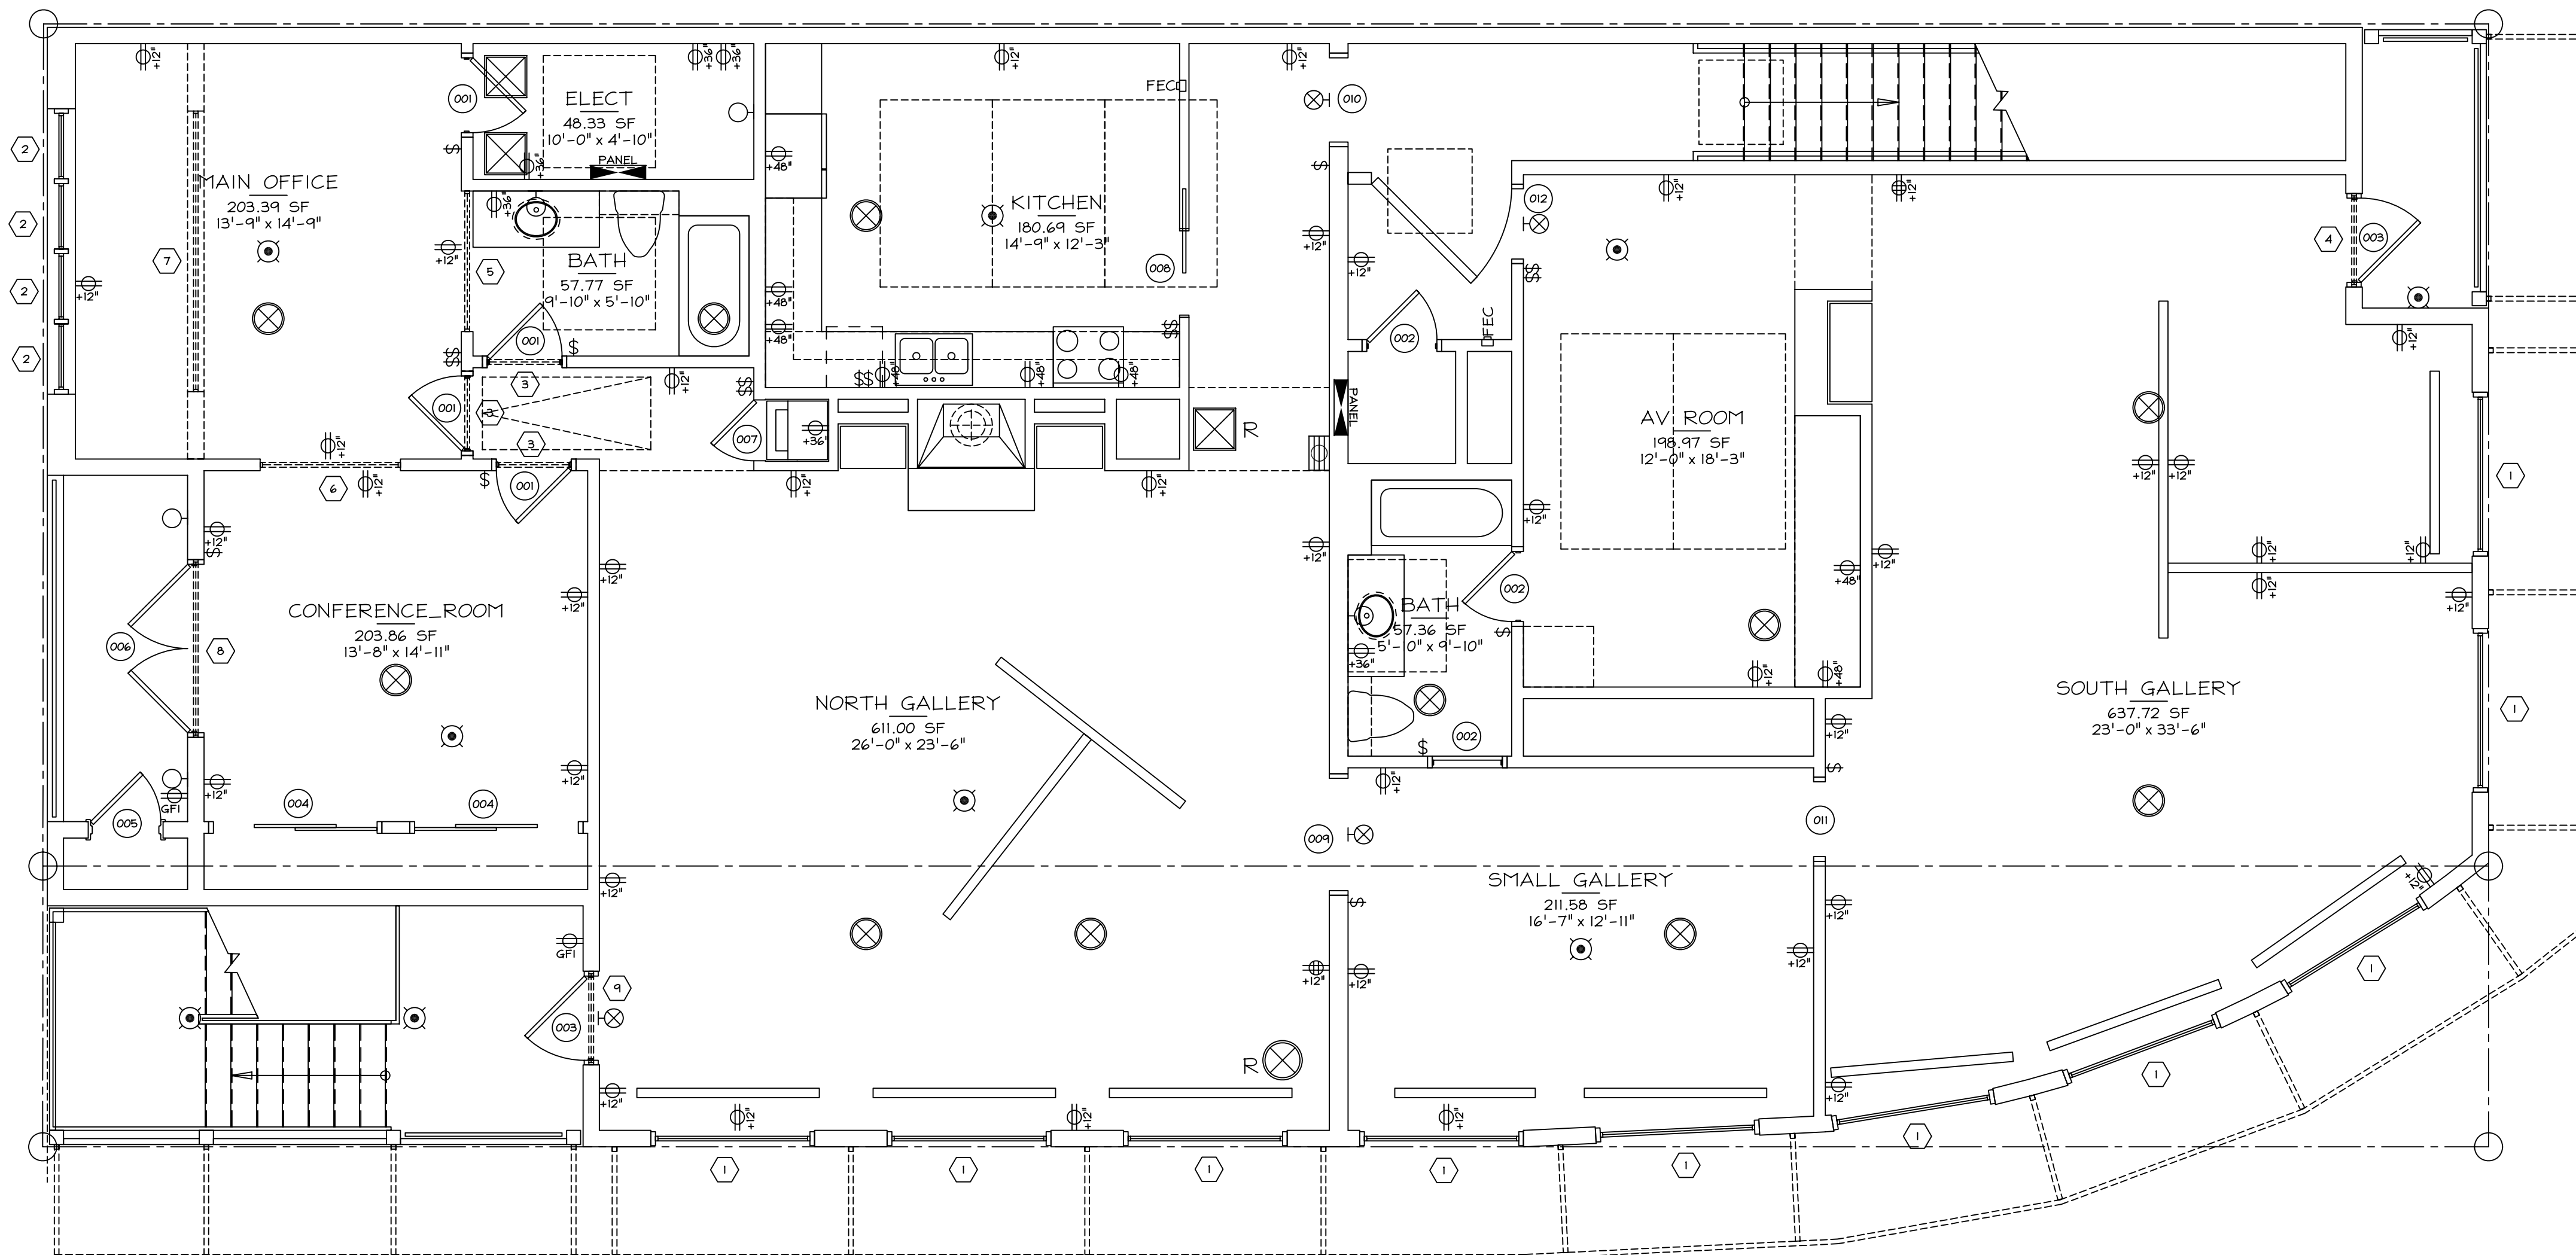

AS-BUILT EXAMPLES
NOT TO SCALE

NO.	ISSUE/REVISION	DATE
-----	----------------	------


PROJECT _____

SCALE _____

DRAWN BY _____

DATE _____

DRAWING NO. _____
SPECIALTY PROJECTS

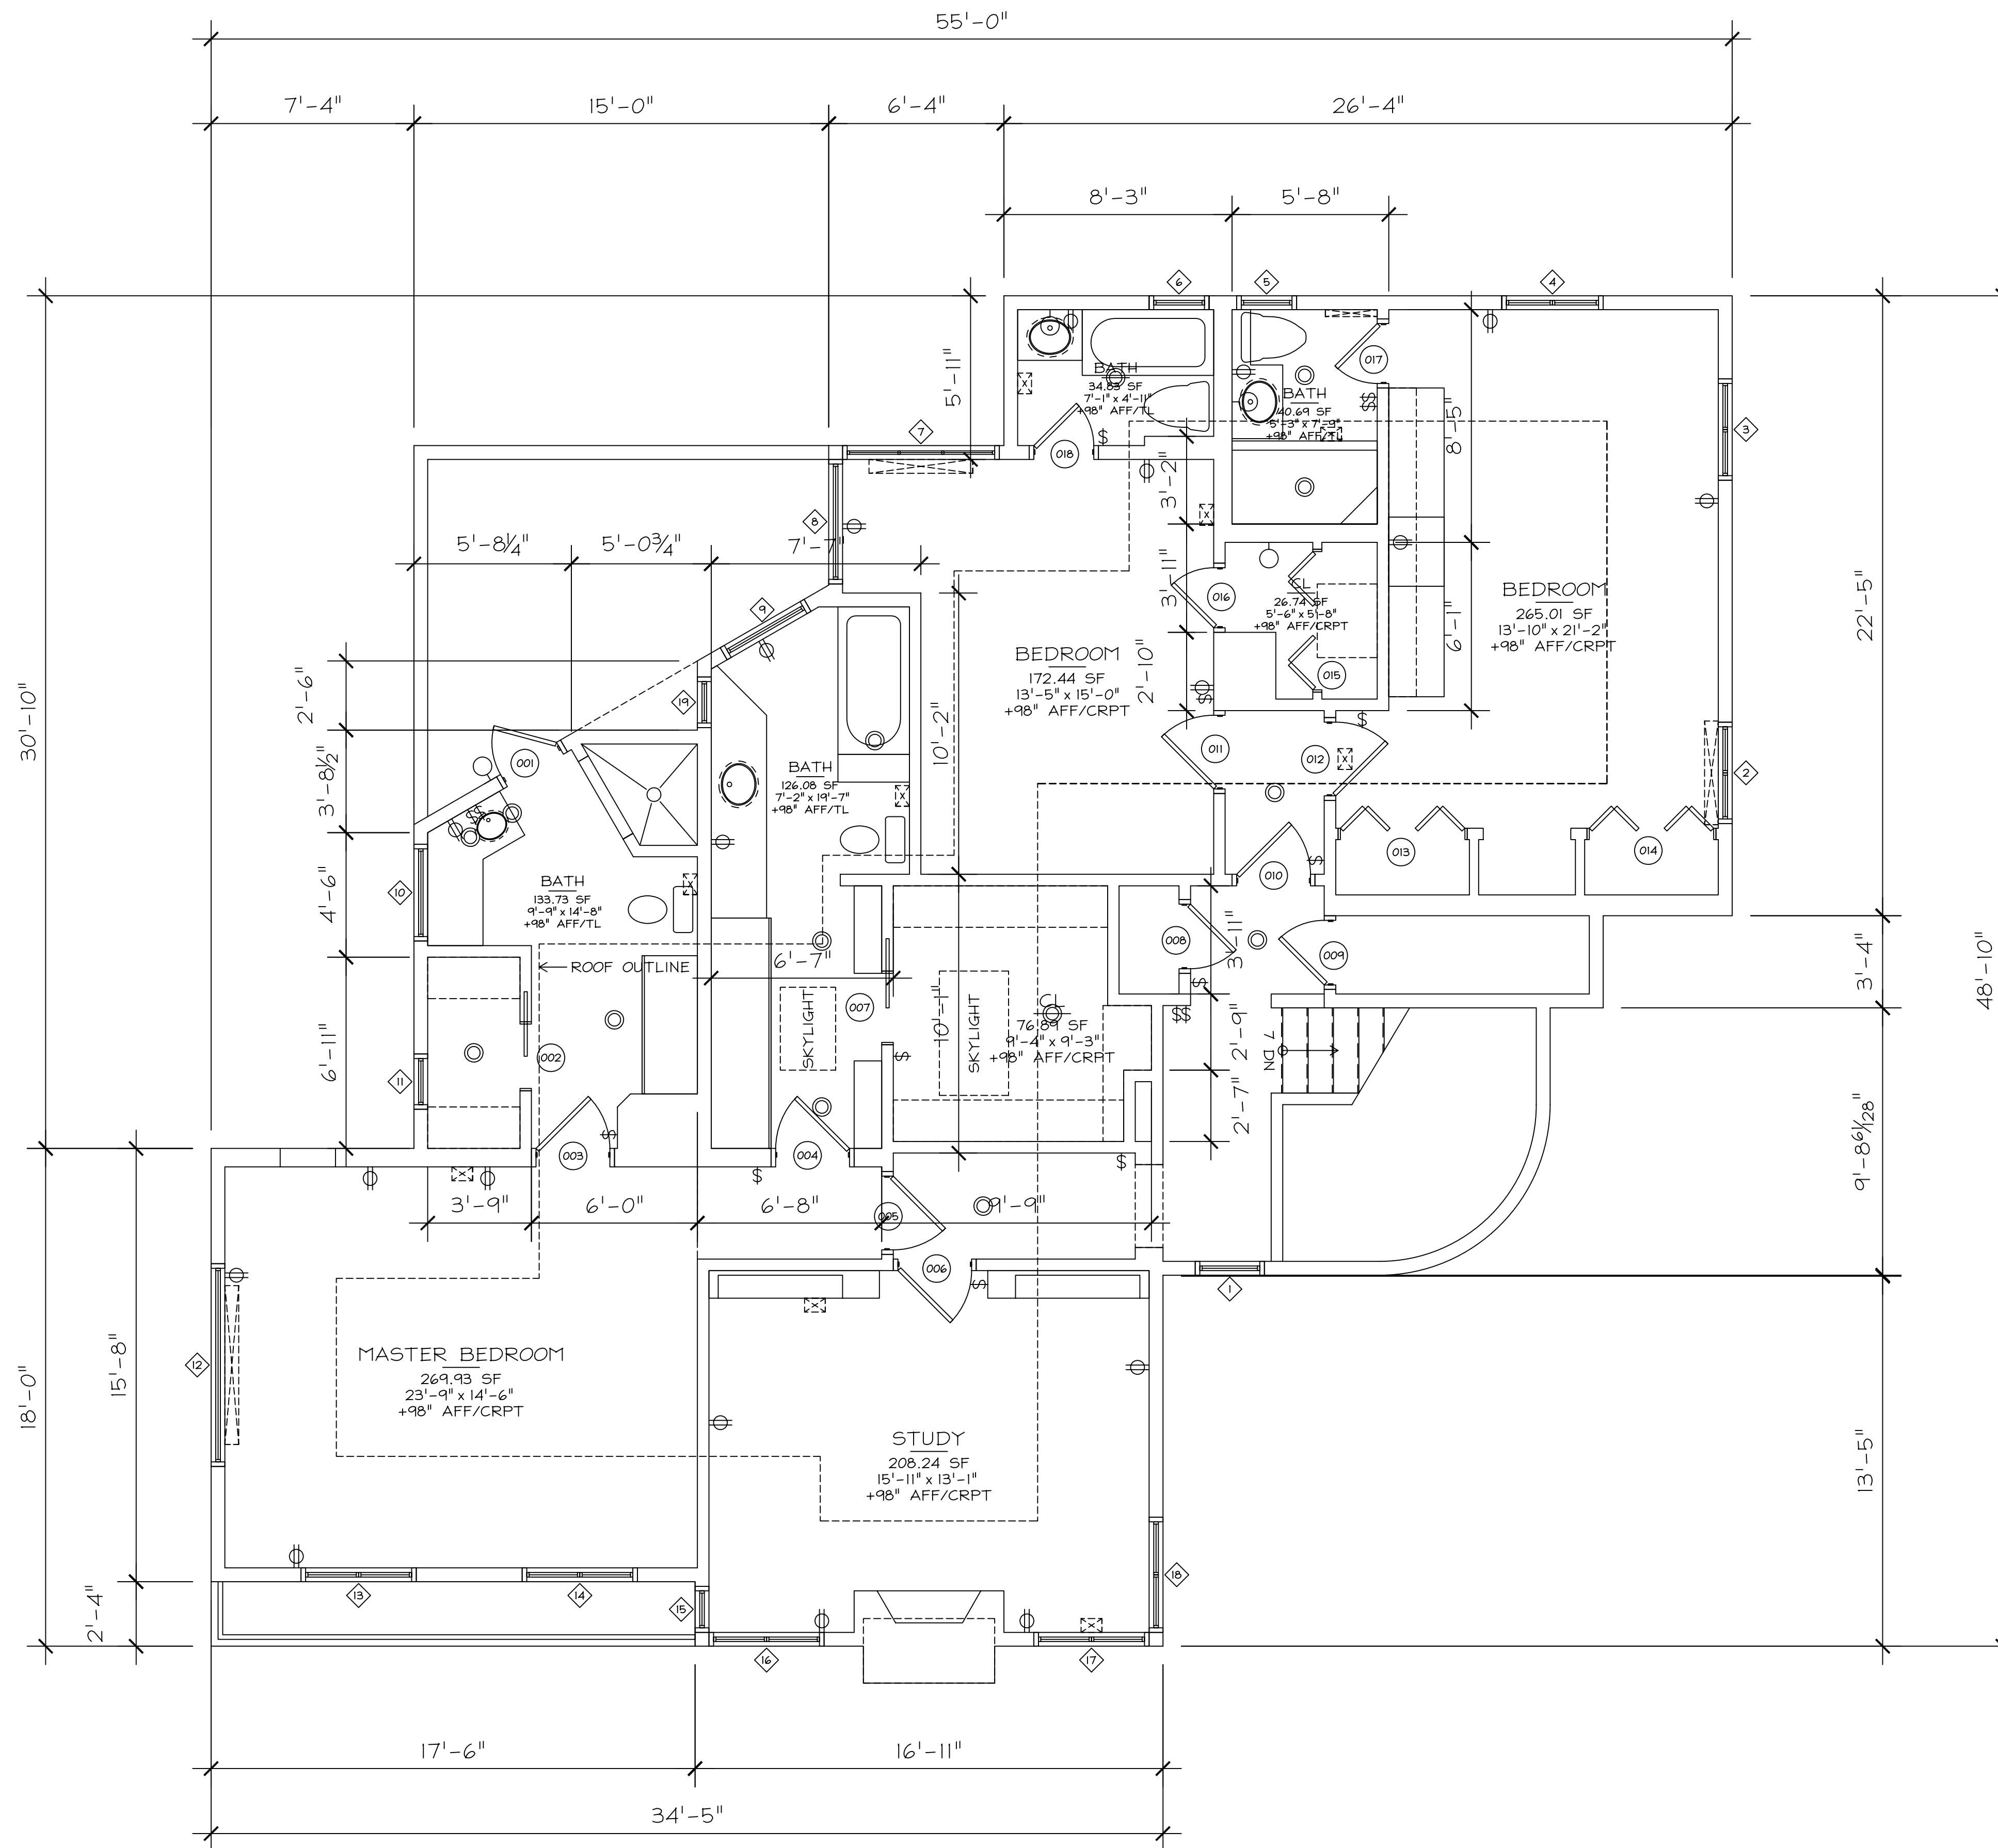

AS-BUILT EXAMPLES

NOT TO SCALE

NO. ISSUE/REVISION DATE


PROJECT _____

SCALE _____

DRAWN BY _____

DATE _____

DRAWING NO.
RESIDENTIAL

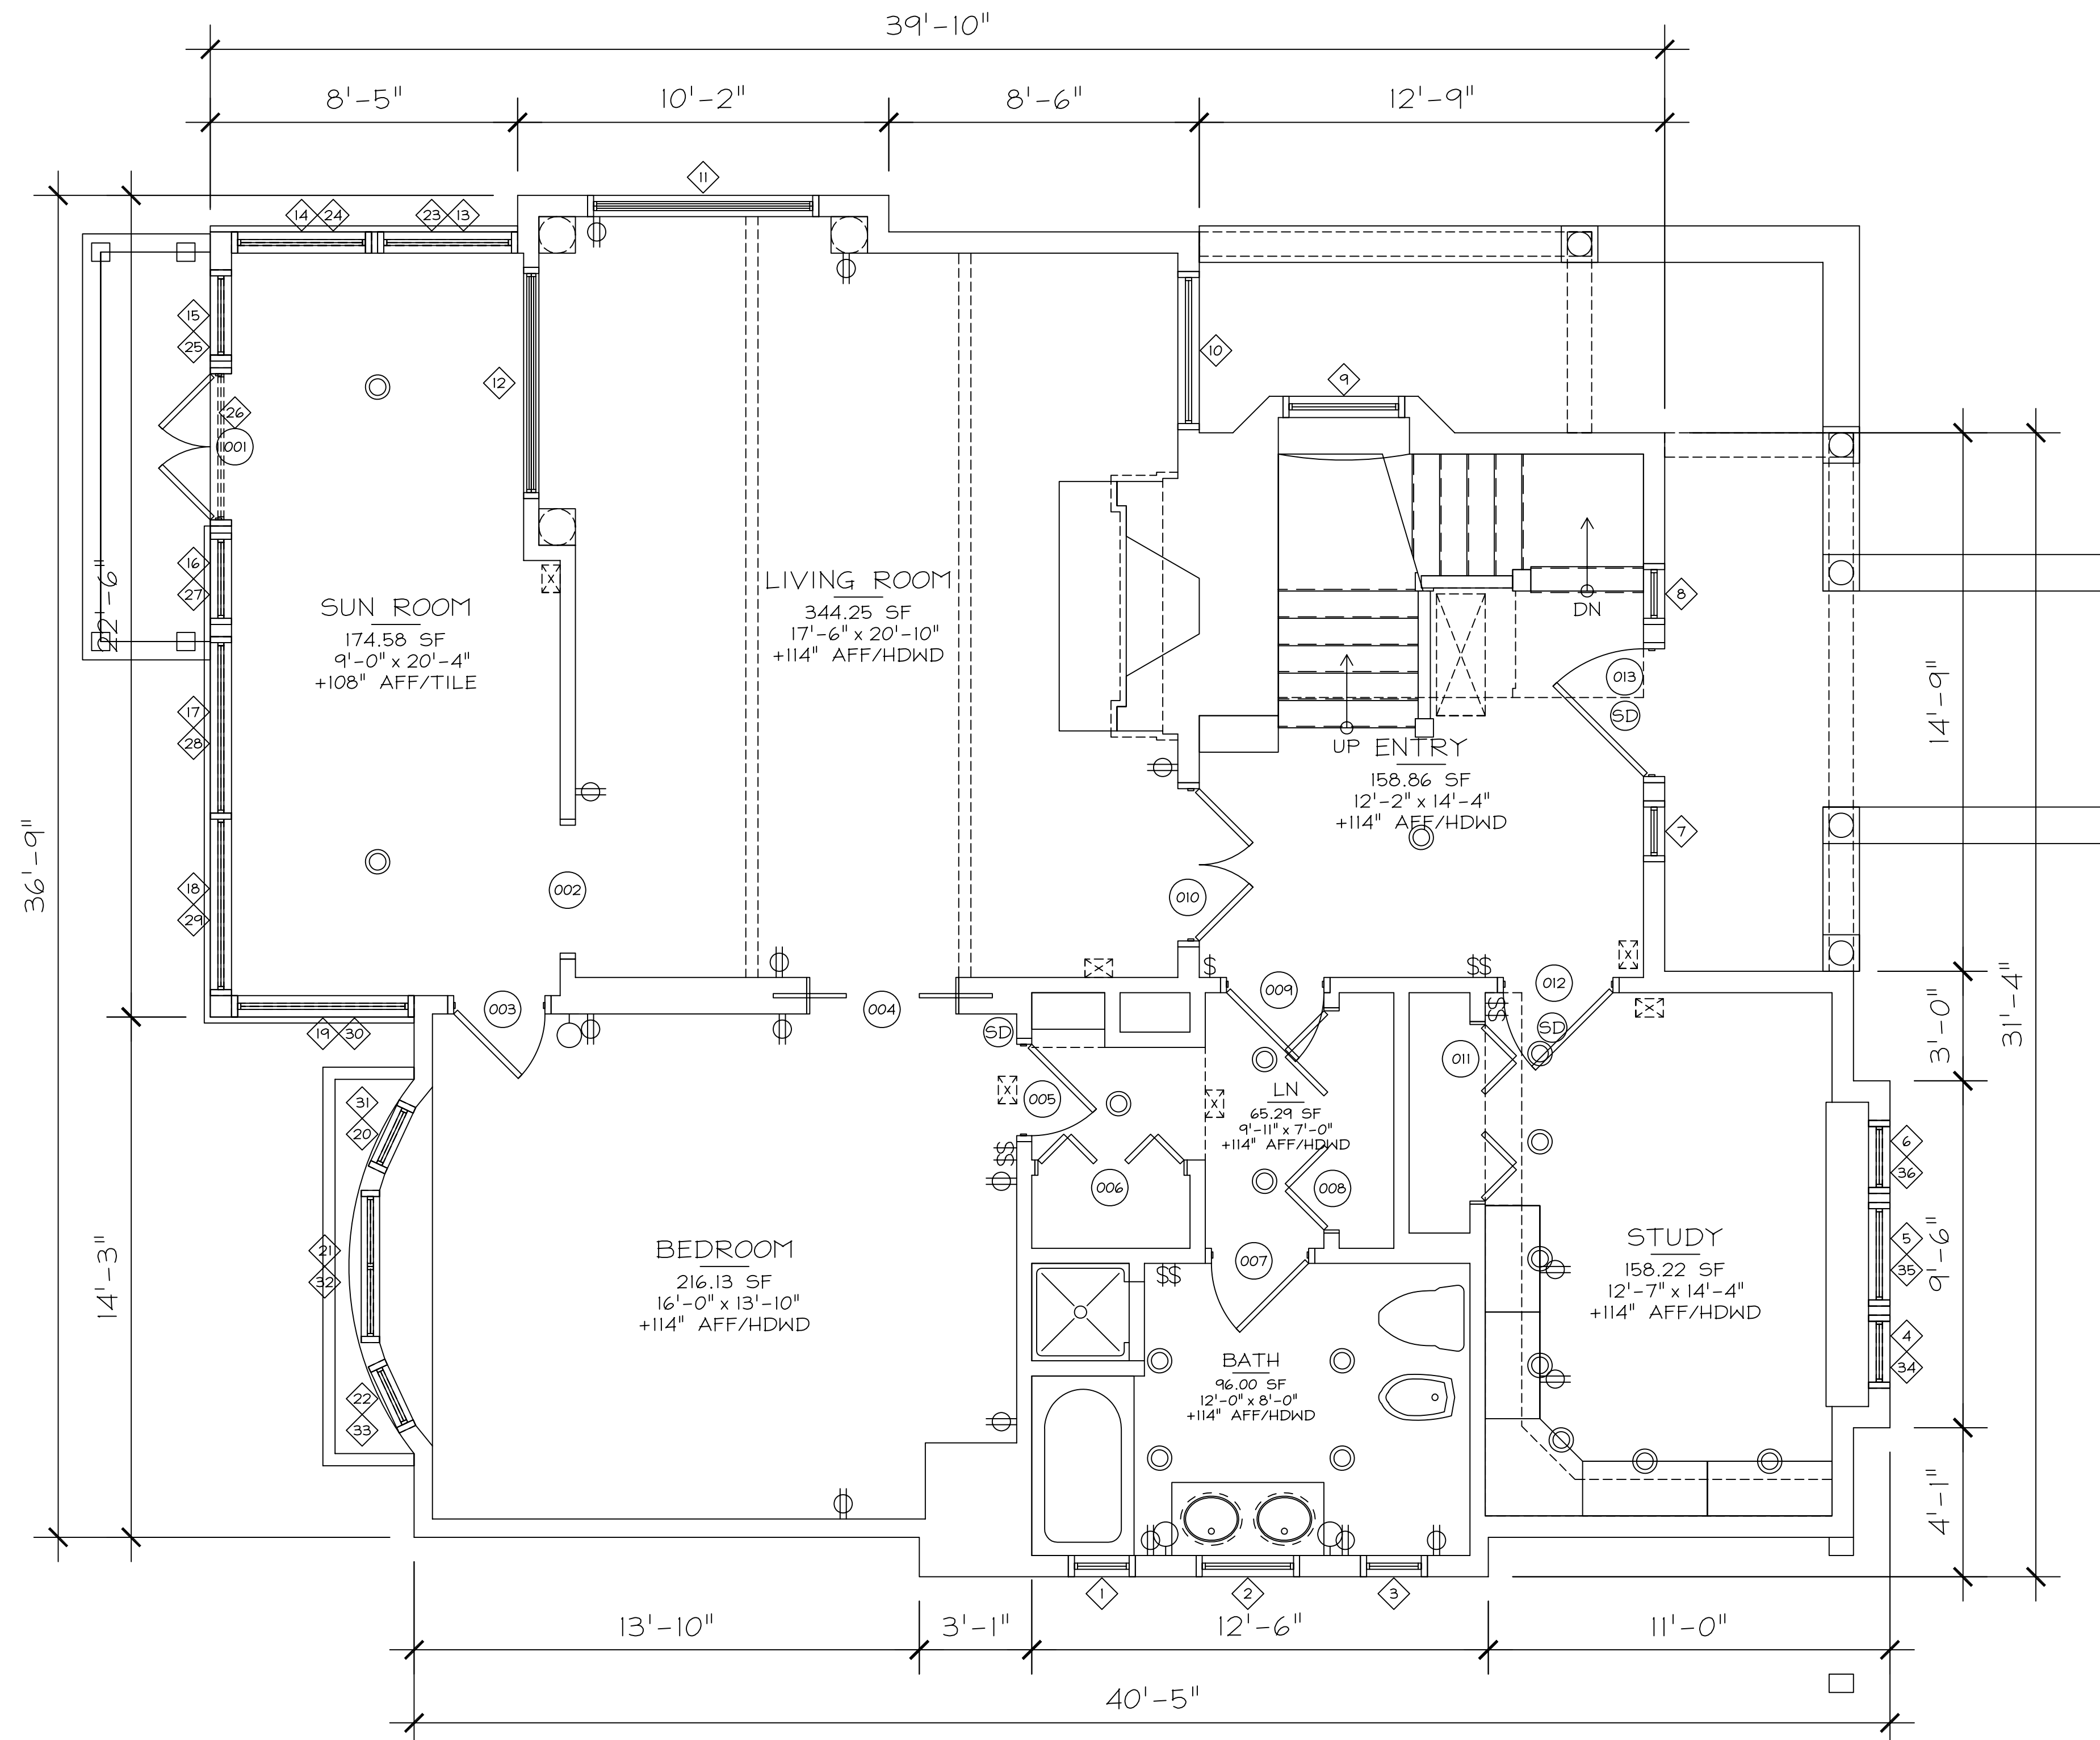


AS-BUILT EXAMPLES
NOT TO SCALE

NO. ISSUE/REVISION DATE

PROJECT _____
SCALE _____
DRAWN BY _____
DATE _____

DRAWING NO. RESIDENTIAL

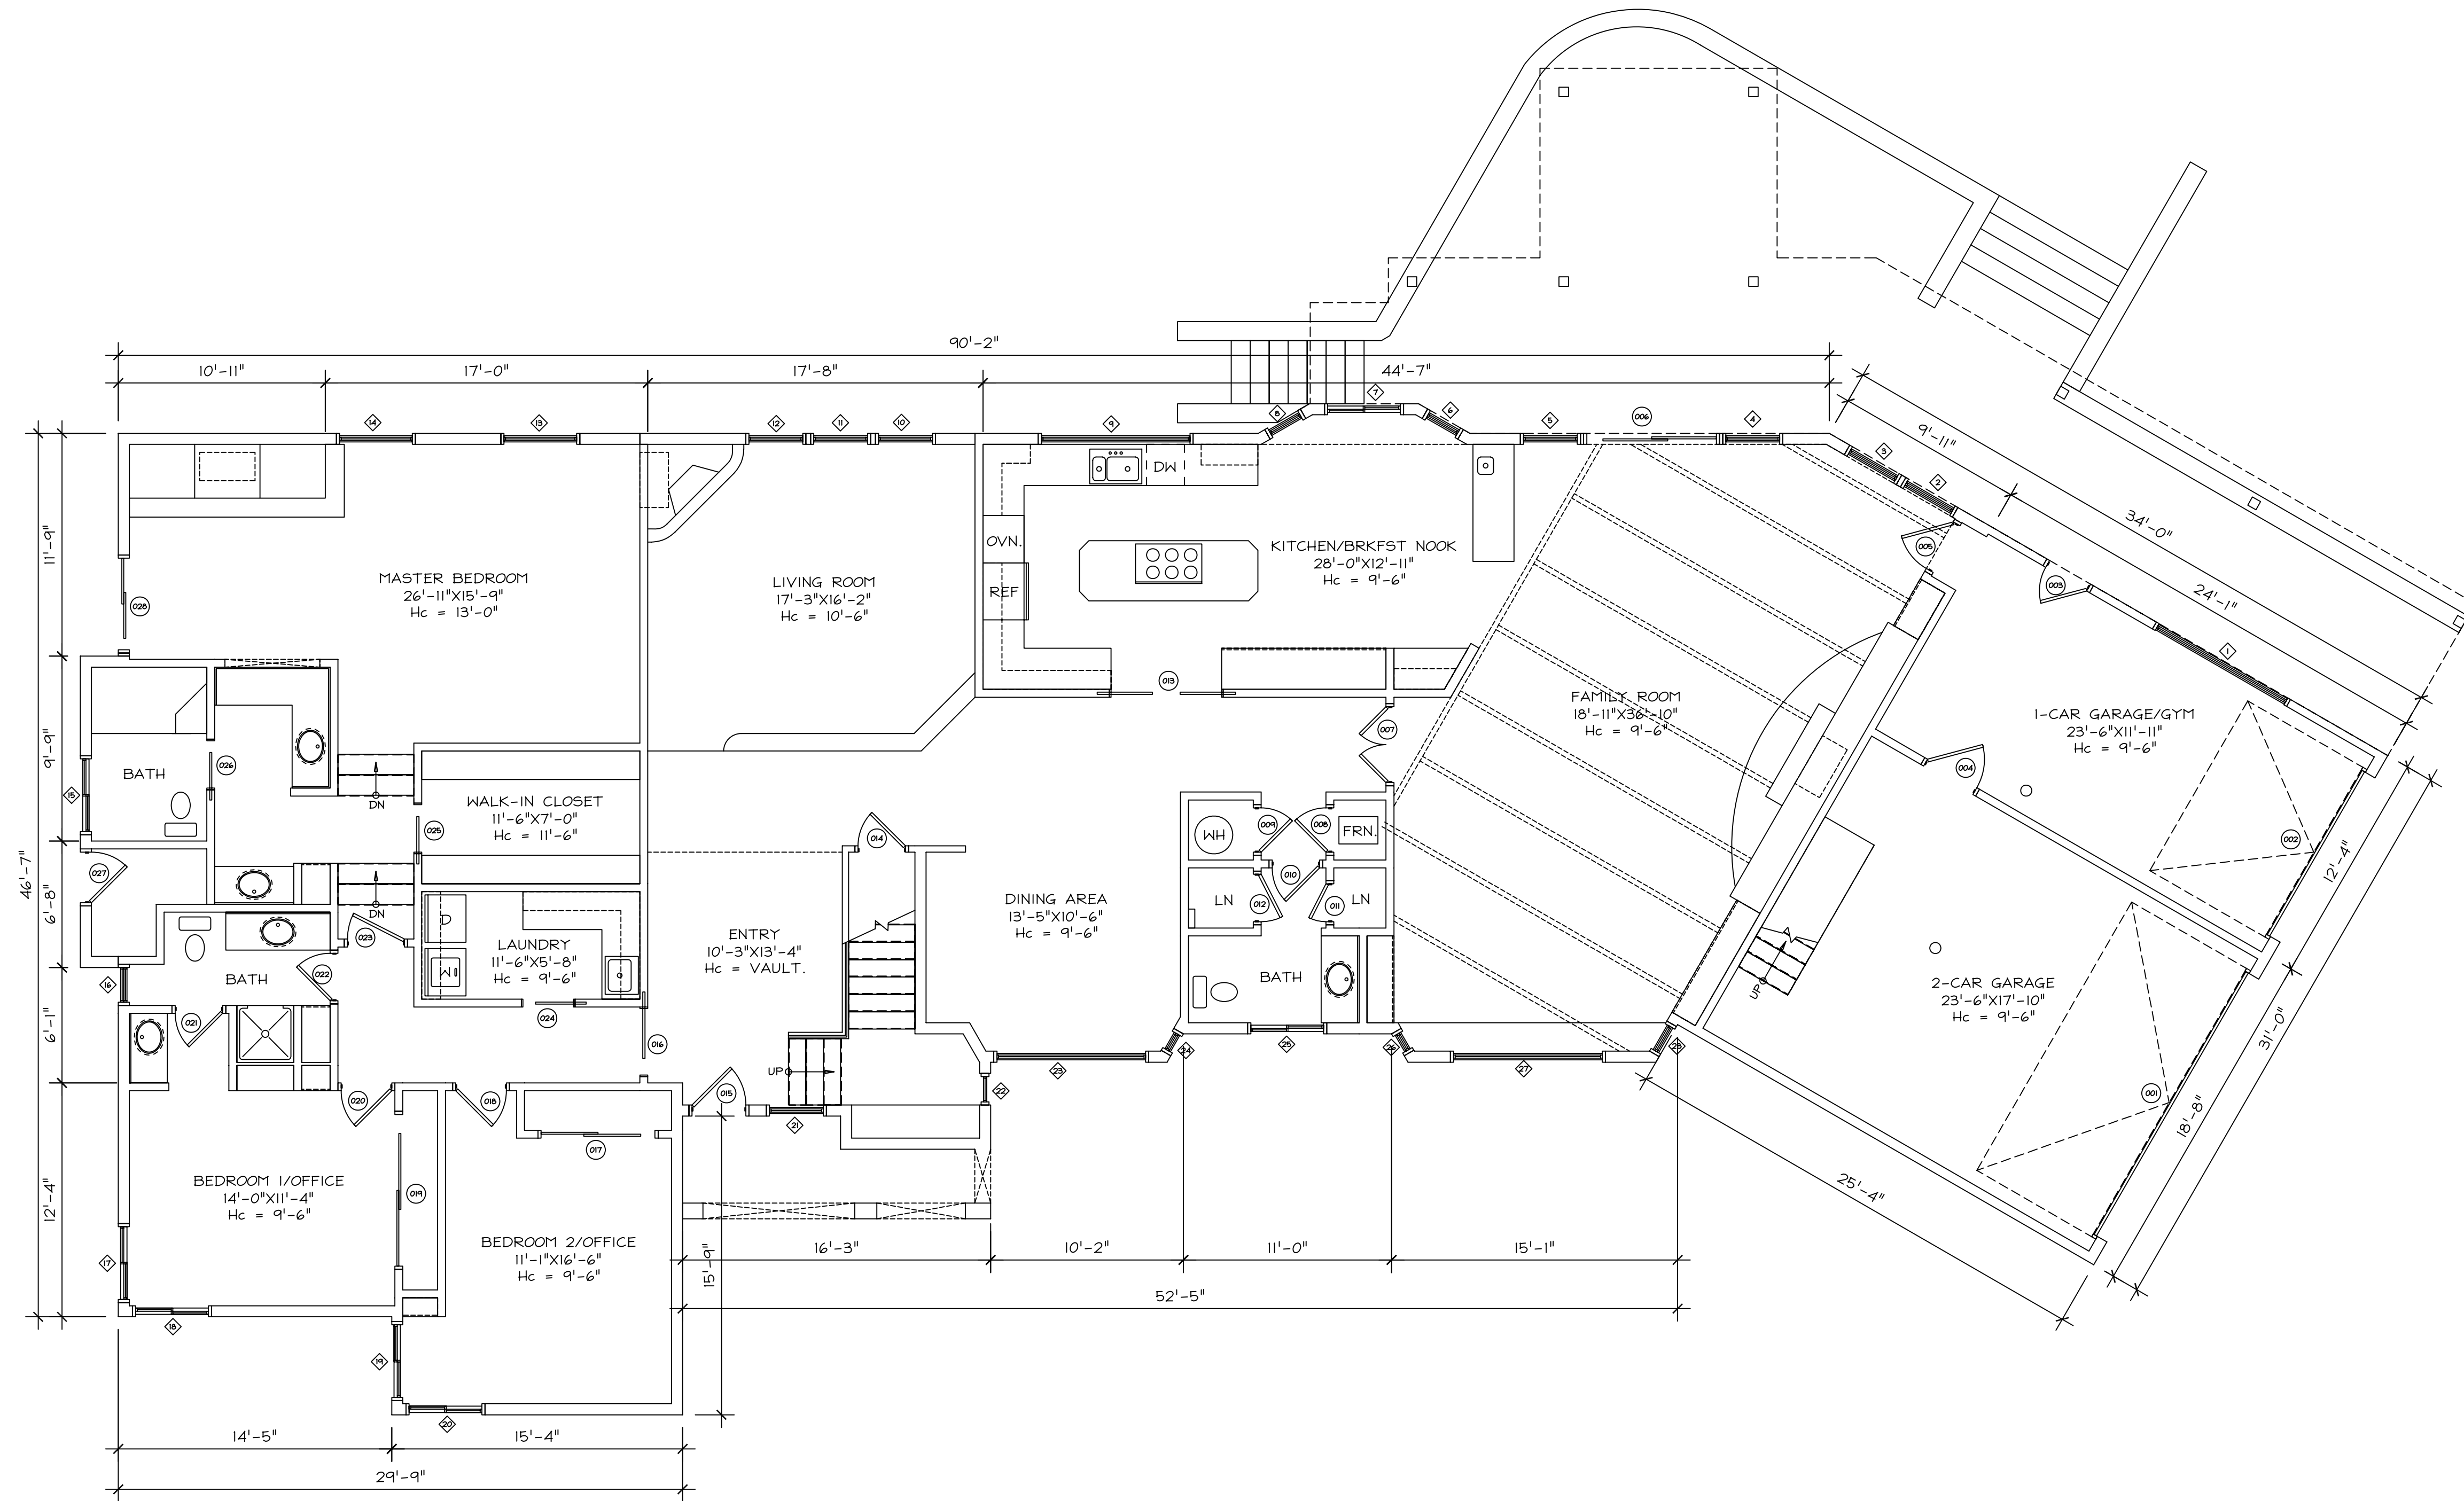

AS-BUILT EXAMPLES

NOT TO SCALE

NO.	ISSUE/REVISION	DATE

PROJECT _____

SCALE _____

DRAWN BY _____

DATE _____

DRAWING NO.
RESIDENTIAL



AS-BUILT EXAMPLES
NO TO SCALE

NO. ISSUE/REVISION DATE

PROJECT

SCALE

DRAWN BY

DATE

DRAWING NO.
ELEVATIONS



AS-BUILT EXAMPLES
NO TO SCALE

NO. ISSUE/REVISION DATE



PROJECT _____

SCALE _____

DRAWN BY _____

DATE _____

DRAWING NO.
ELEVATIONS

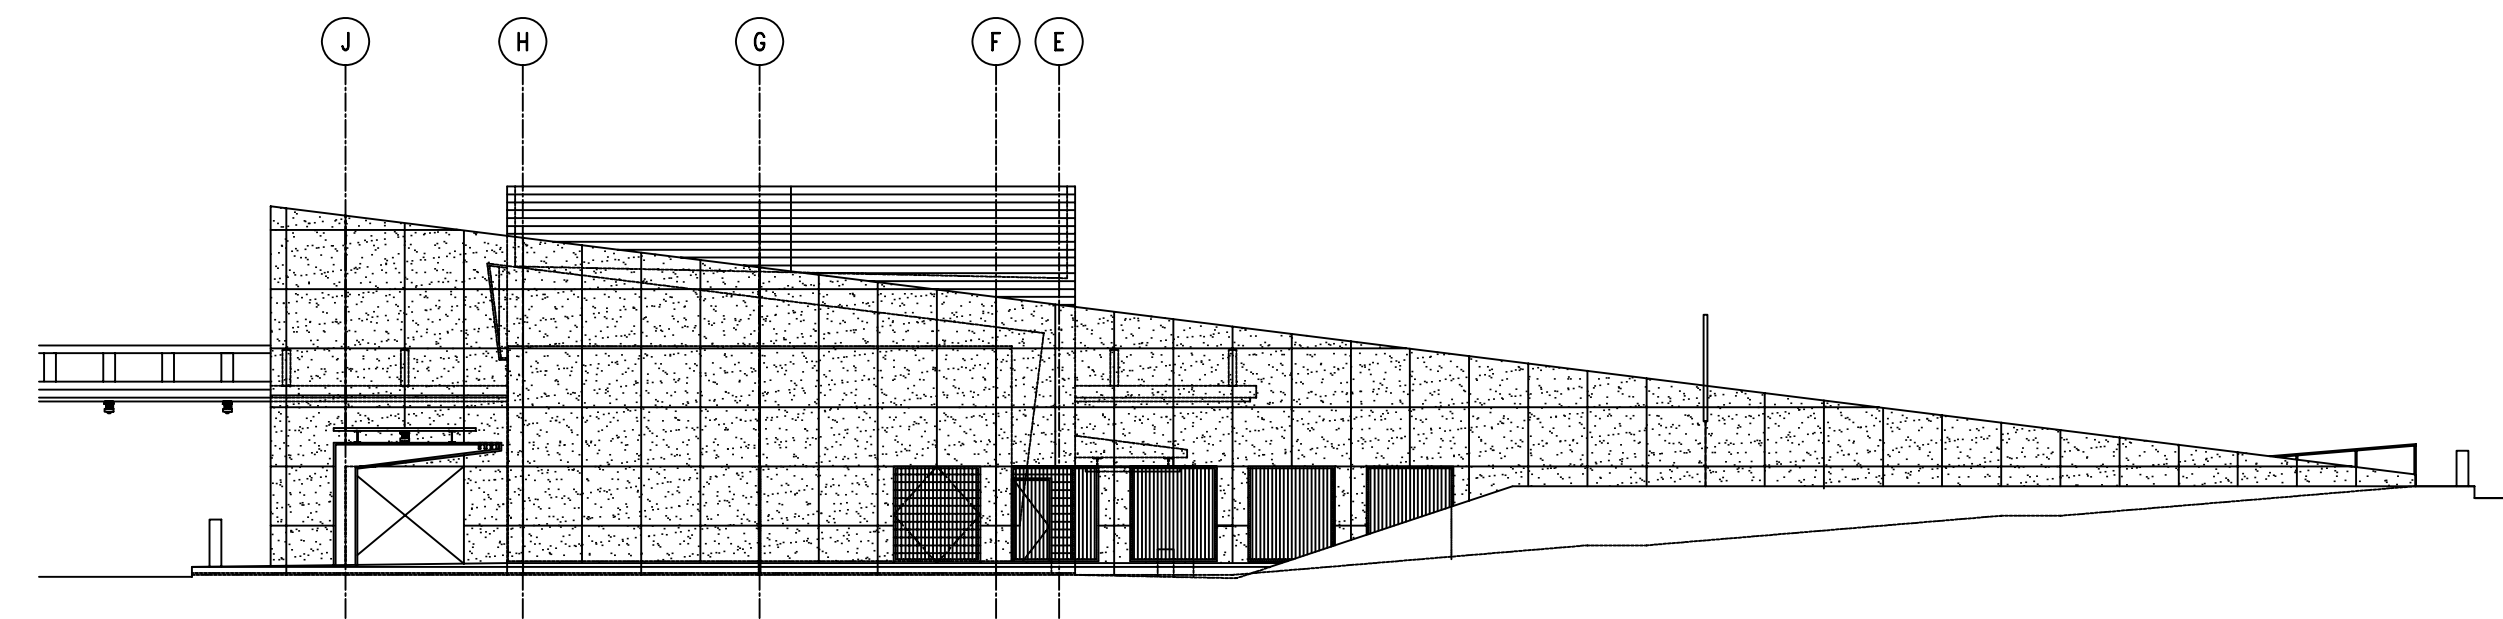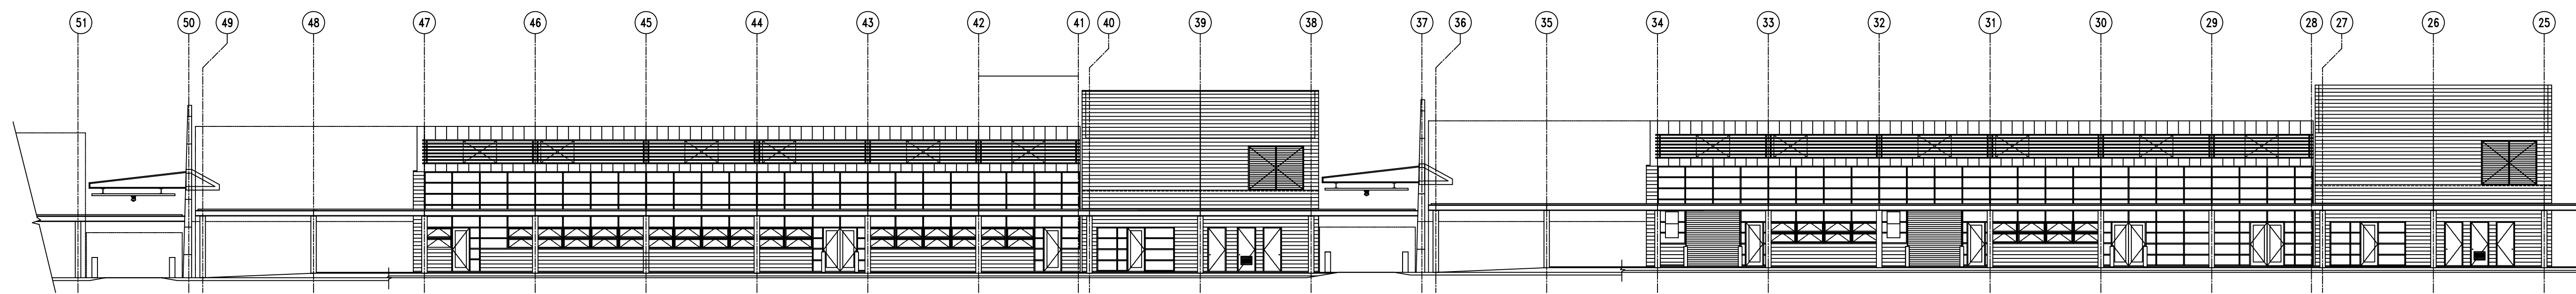

AS-BUILT EXAMPLES
NO TO SCALE

NO. ISSUE/REVISION DATE


PROJECT _____

SCALE _____

DRAWN BY _____


DATE _____

DRAWING NO.
ELEVATIONS

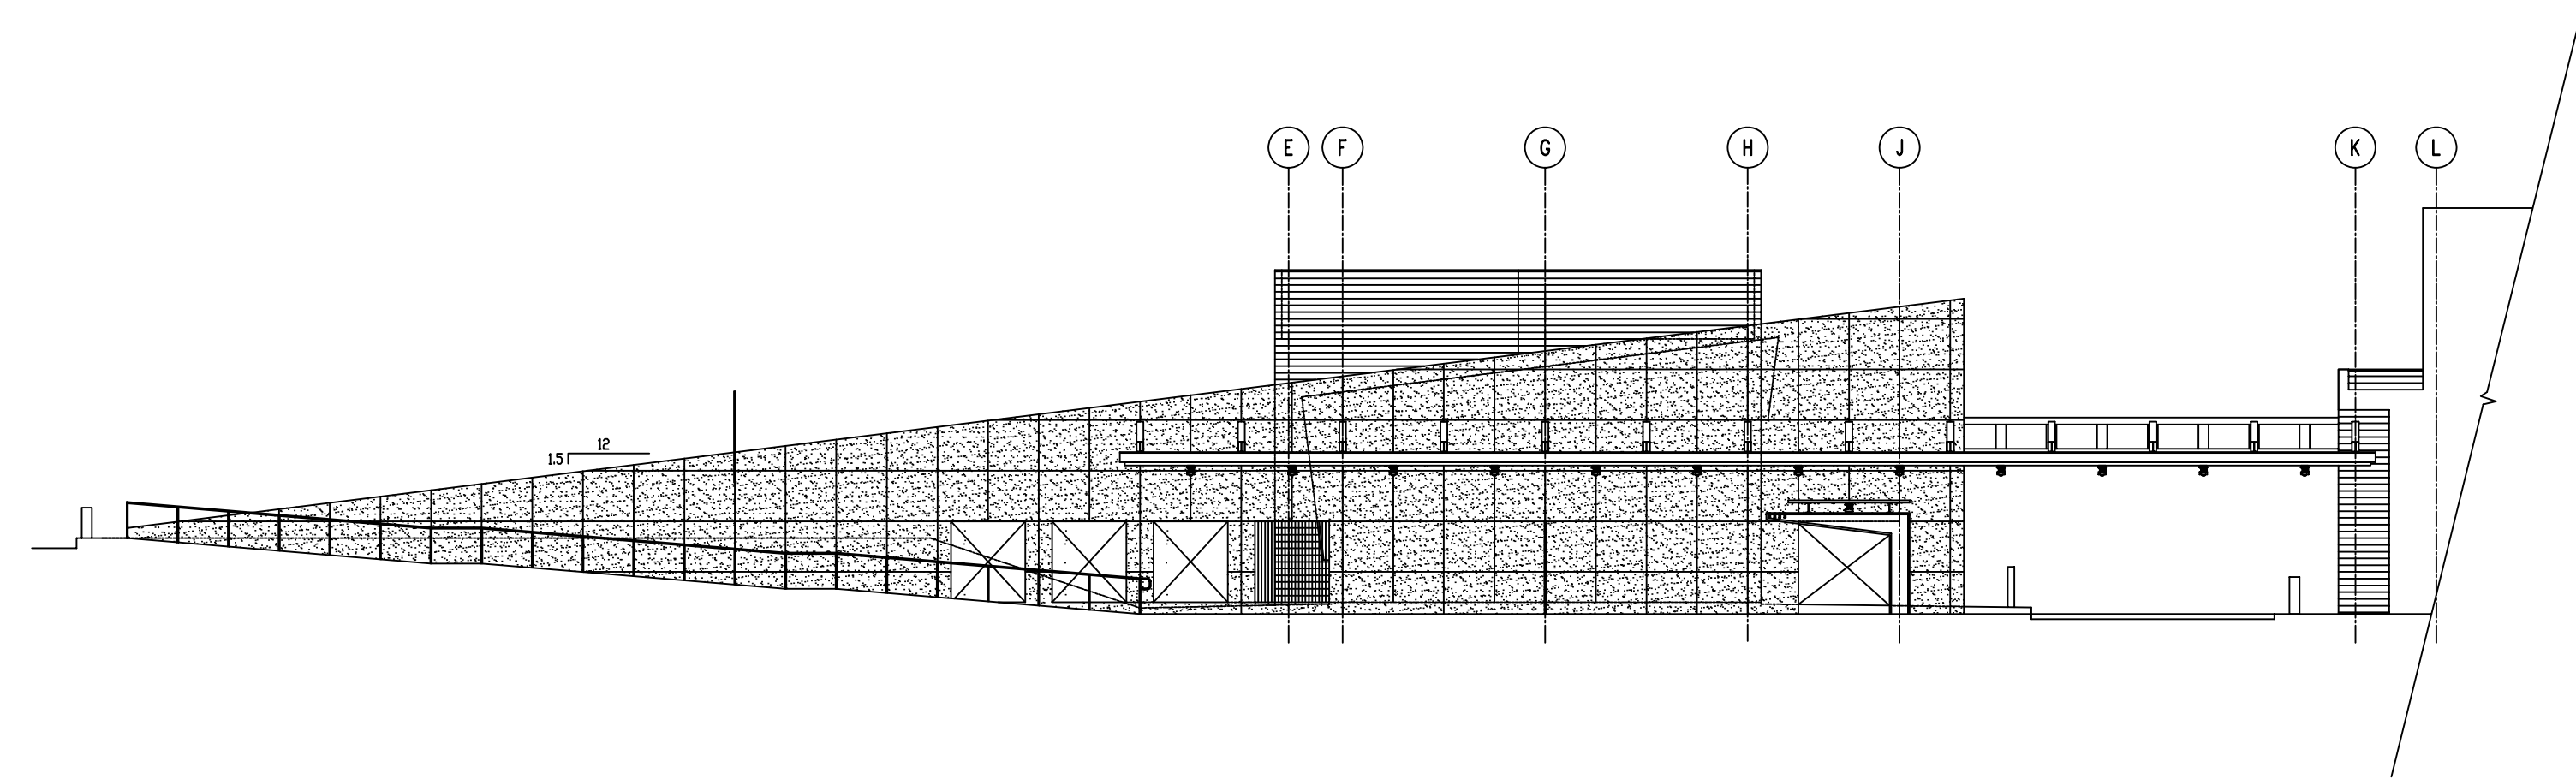

AS-BUILT EXAMPLES
NO TO SCALE

NO. ISSUE/REVISION DATE

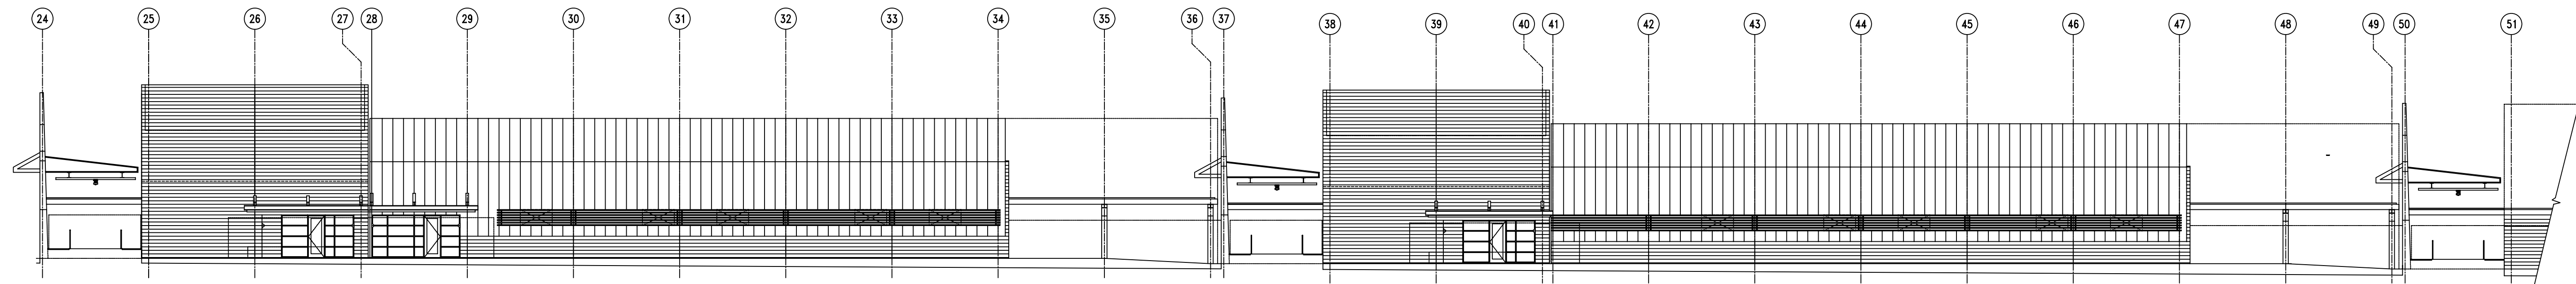

PROJECT _____

SCALE _____

DRAWN BY _____

DATE _____

DRAWING NO.
ELEVATIONS



AS-BUILT EXAMPLES
NO TO SCALE

NO. ISSUE/REVISION DATE

PROJECT _____

SCALE _____

DRAWN BY _____


DATE _____

DRAWING NO.
ELEVATIONS

PRIMEEDGE

ASBUILT SERVICES

1684 Decoto Rd., #157
Union City CA, 94587
(510) 499-4148 Tel.
(510) 794-4178 Fax
www.PrimeEdge.com

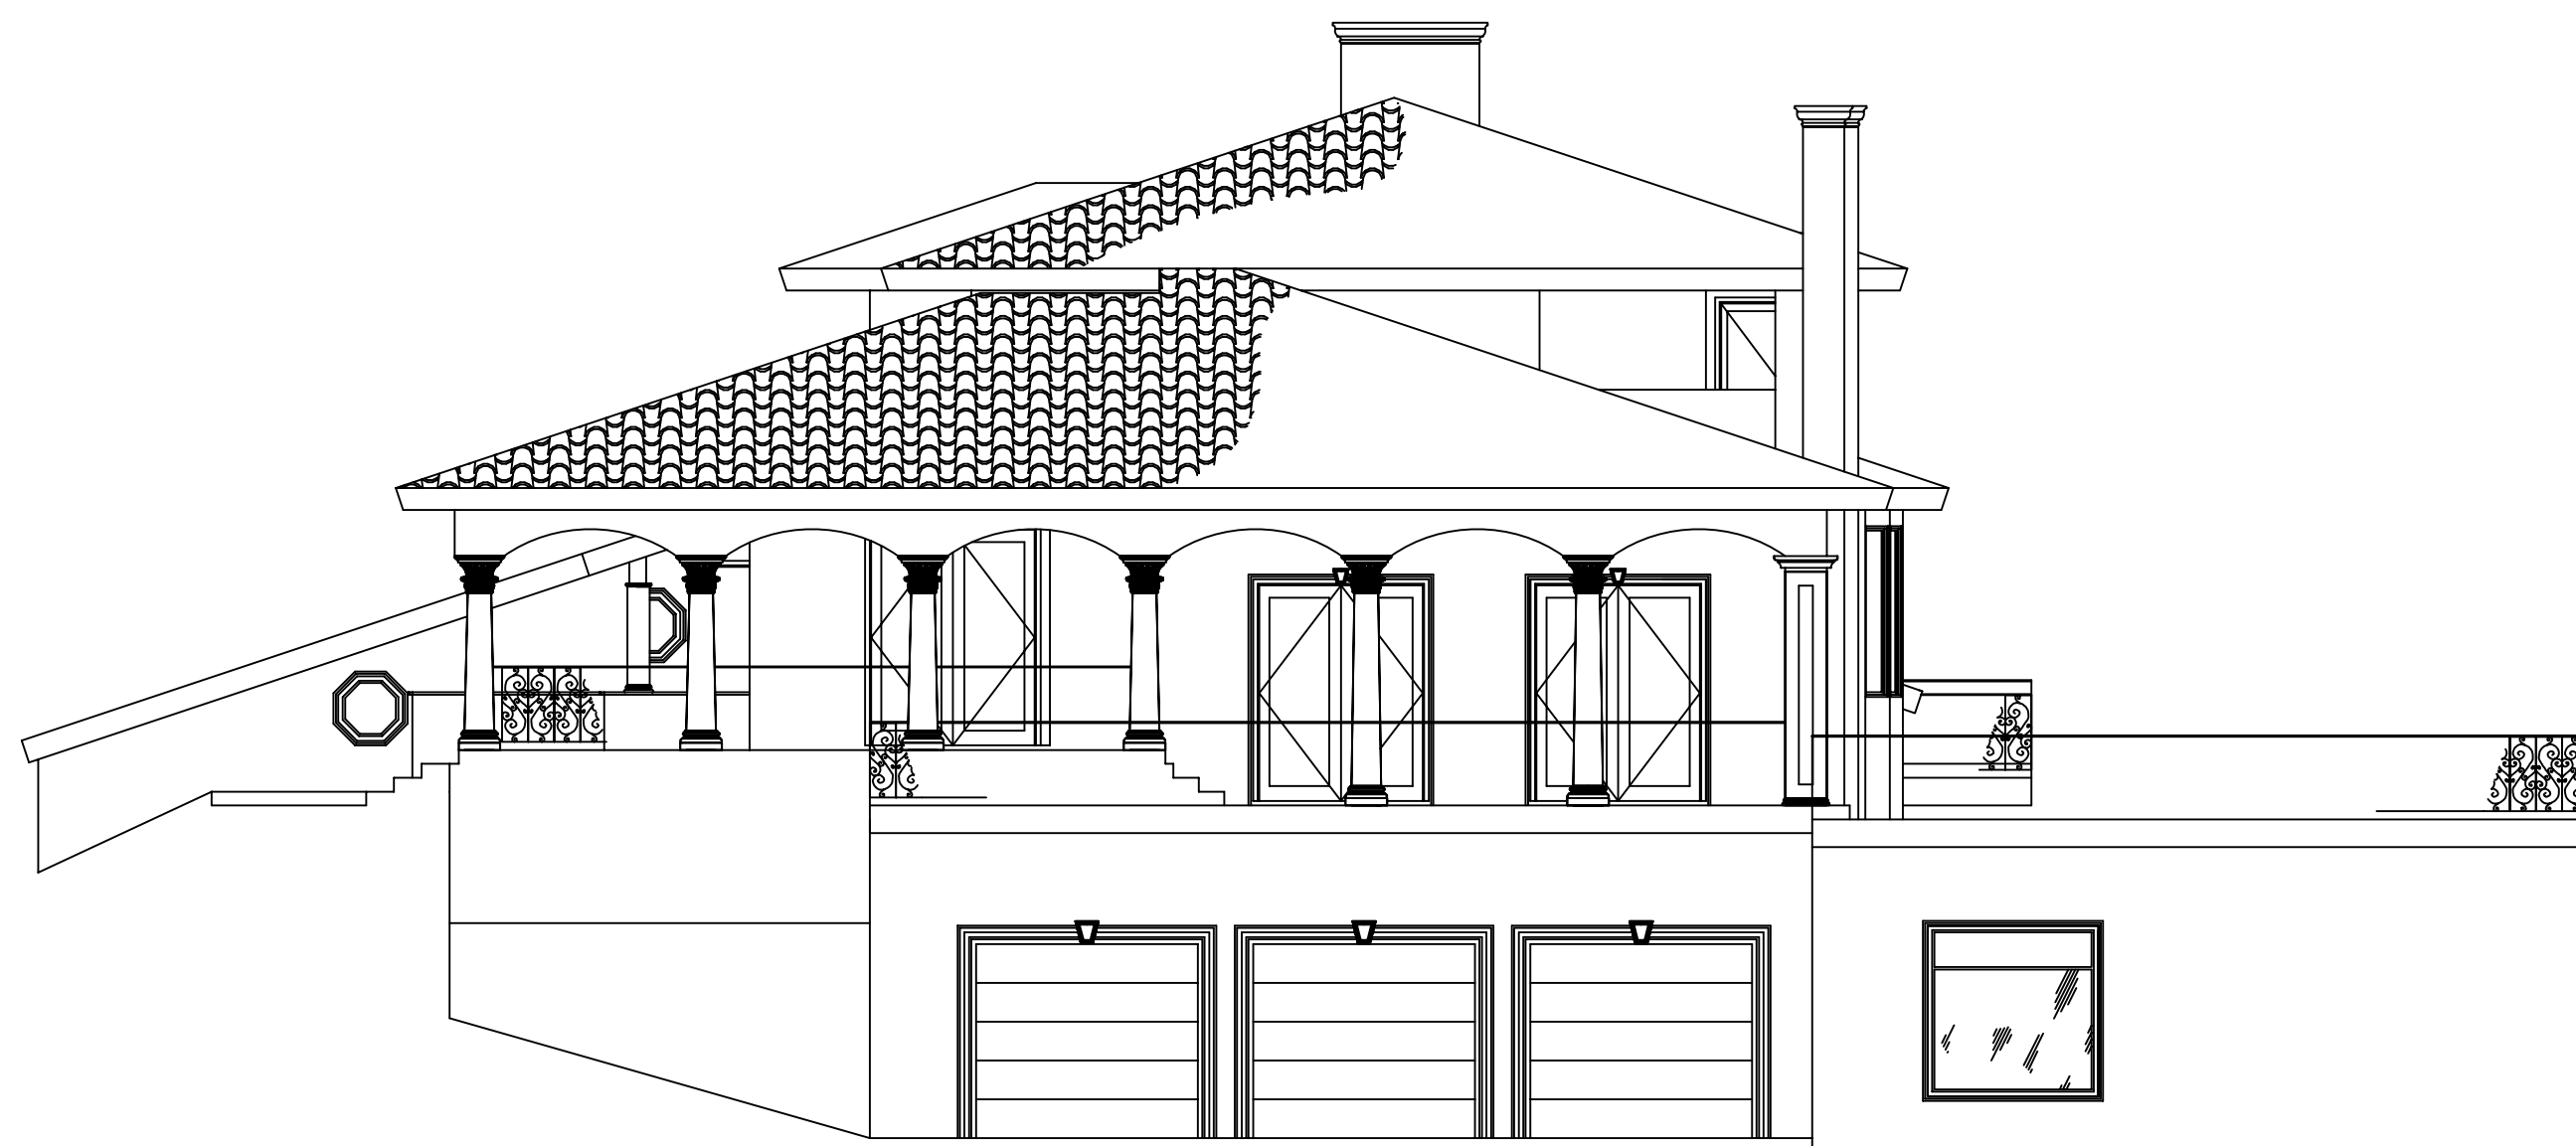

AS-BUILT EXAMPLES
NO TO SCALE

NO. ISSUE/REVISION DATE

PROJECT _____

SCALE _____

DRAWN BY _____

DATE _____


DRAWING NO.
ELEVATIONS

A4.5

PRIMEEDGE


ASBUILT SERVICES

1684 Decoto Rd., #157
Union City CA, 94587
(510) 499-4148 Tel.
(510) 794-4178 Fax
www.PrimeEdge.com

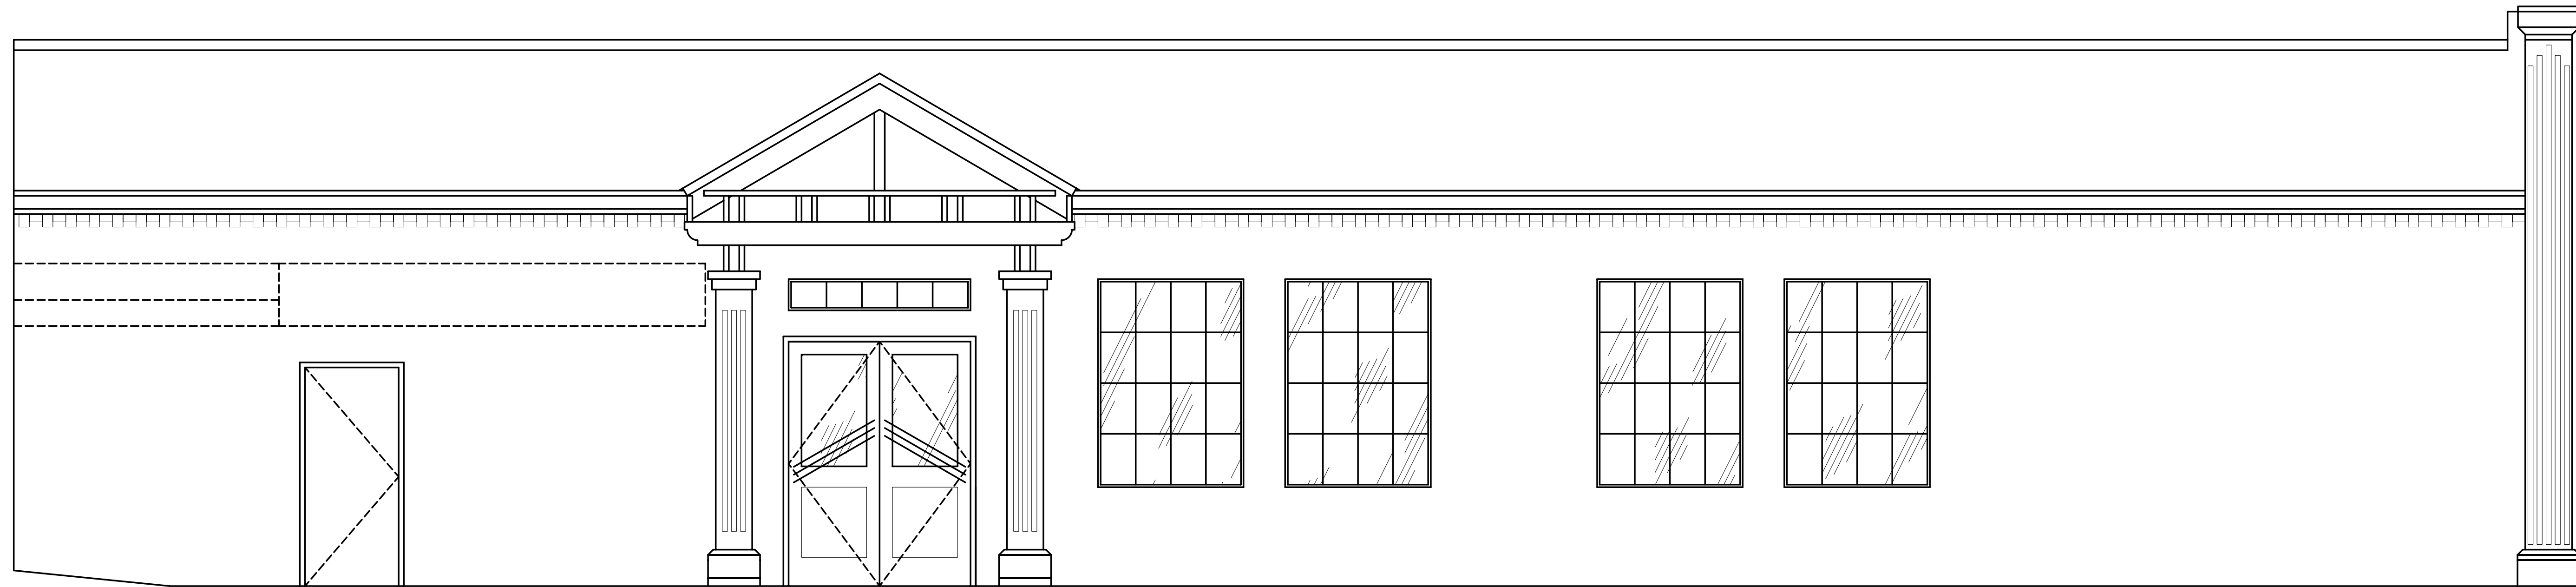

AS-BUILT EXAMPLES
NO TO SCALE

NO. ISSUE/REVISION DATE

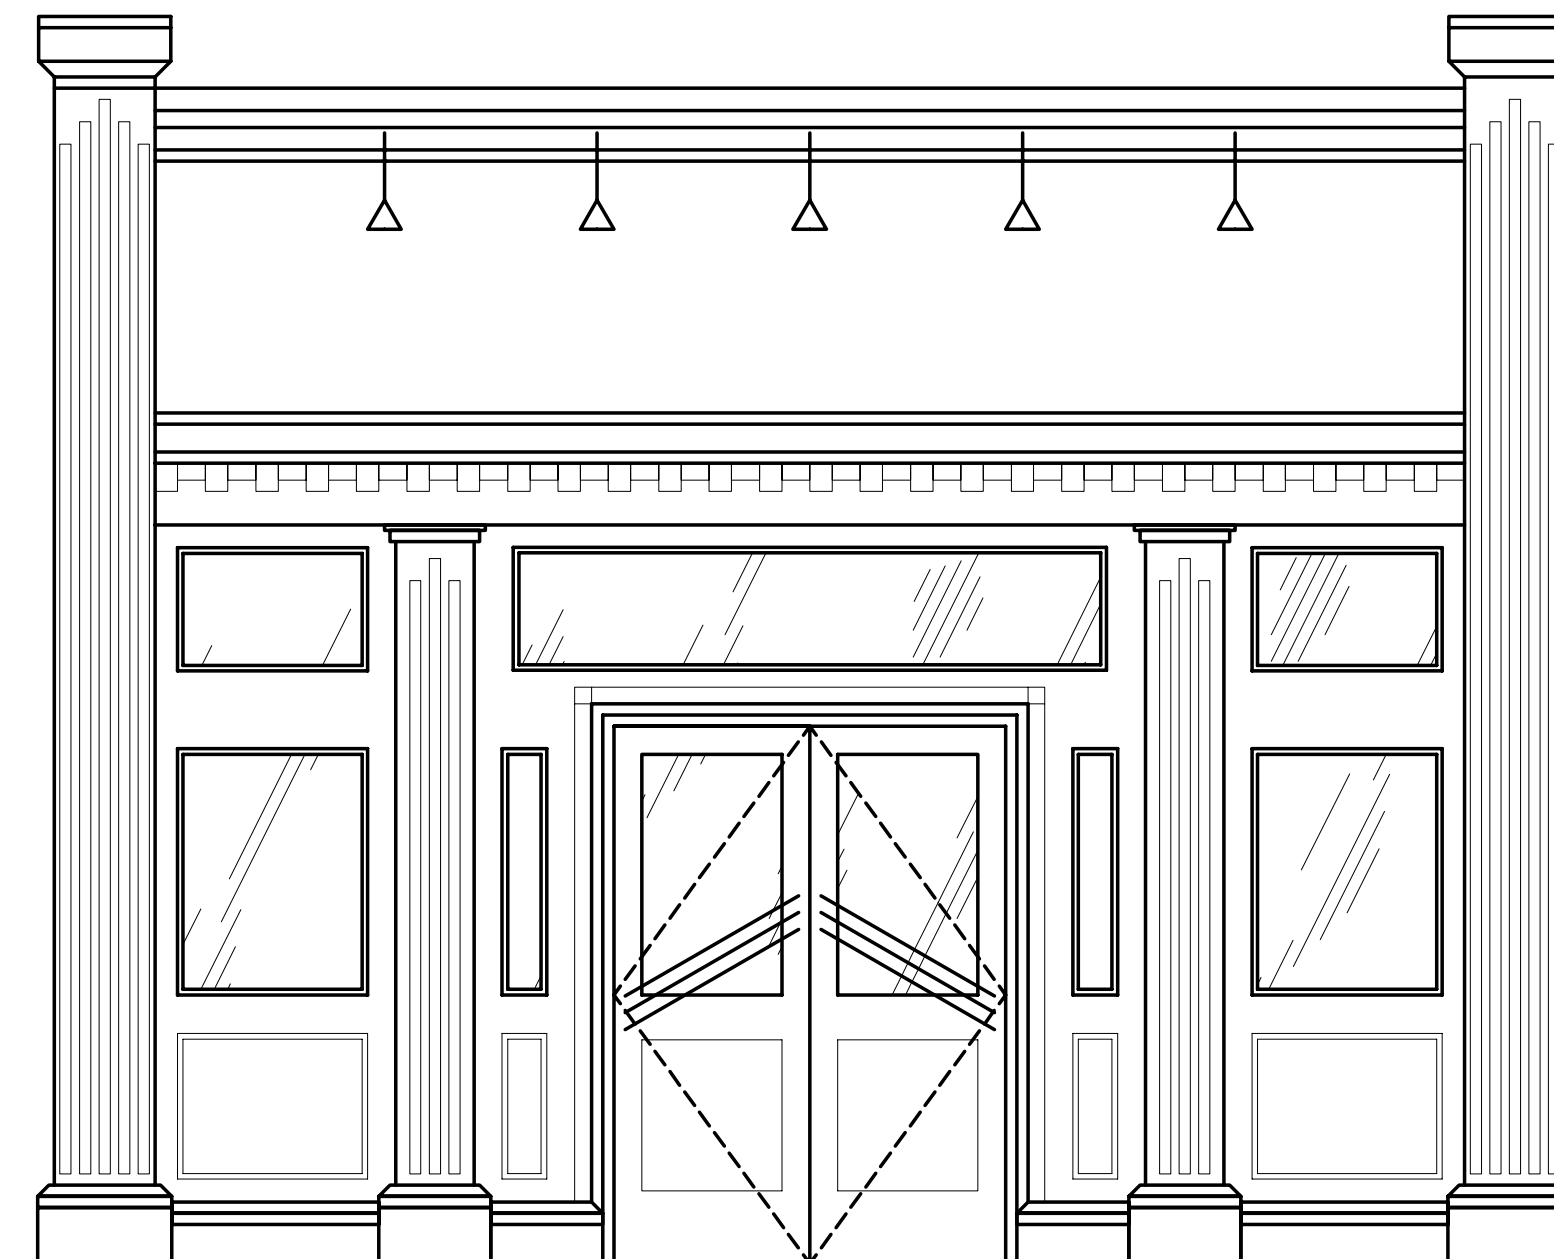


PROJECT _____

SCALE _____

DRAWN BY _____


DATE _____

DRAWING NO.
ELEVATIONS

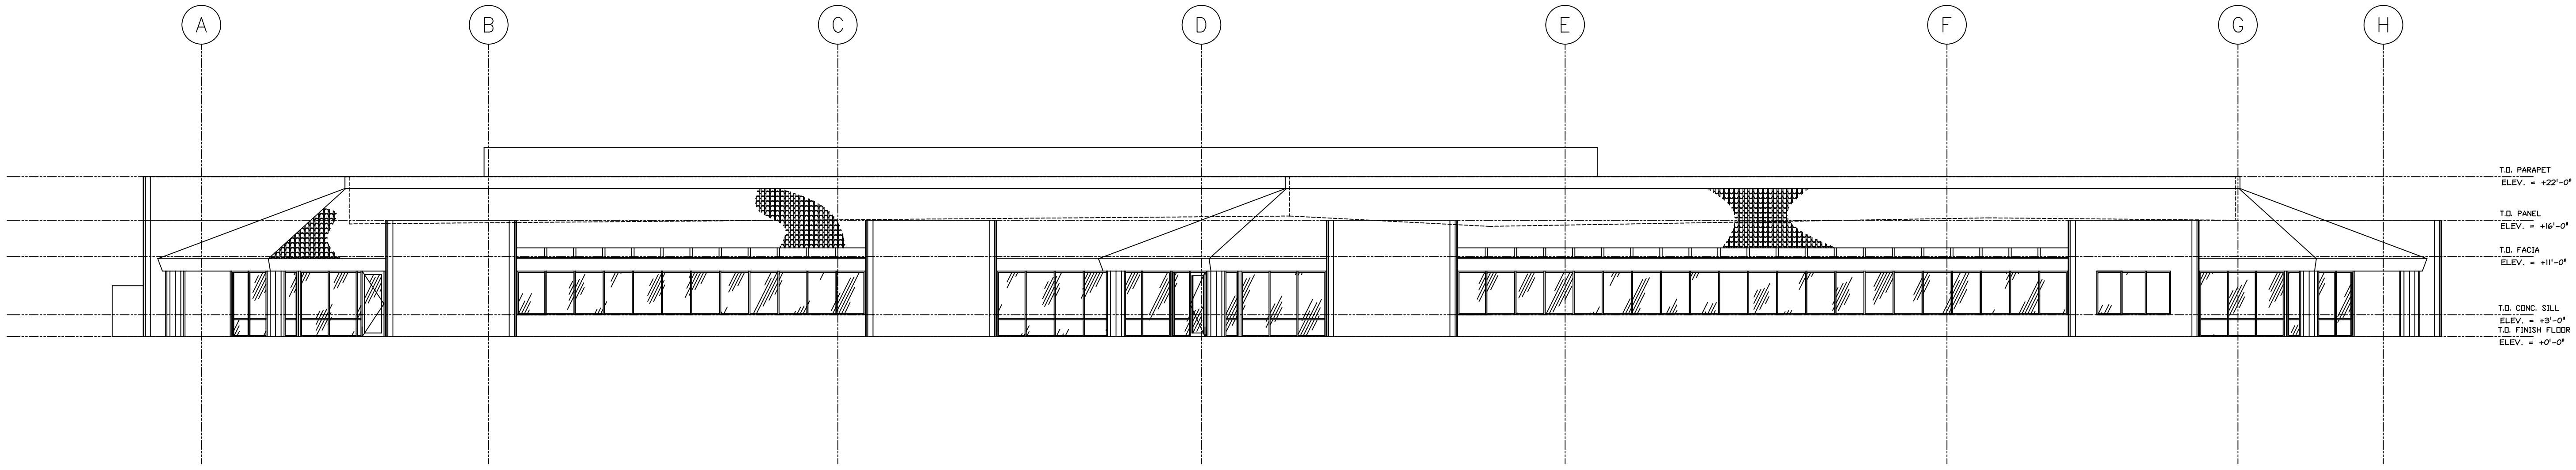

AS-BUILT EXAMPLES
NO TO SCALE

NO. ISSUE/REVISION DATE

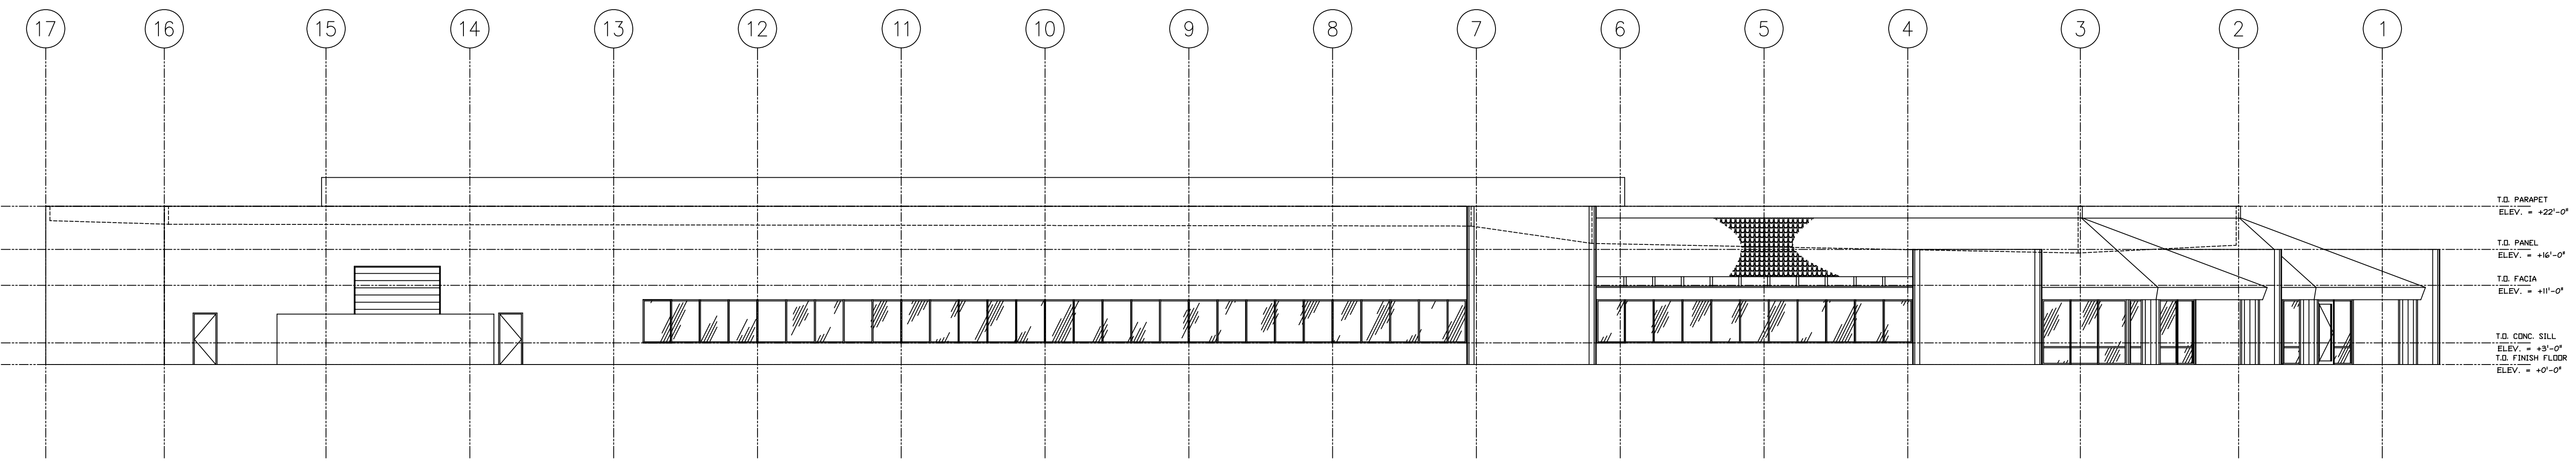

PROJECT _____

SCALE _____

DRAWN BY _____

DATE _____

DRAWING NO.
ELEVATIONS